

TIPPAH  
 J48  
 7-17-72

MISSISSIPPI  
 BOARD OF WATER COMMISSIONERS  
 416 North State Street  
 Jackson, Mississippi 39201

**CODED**

WATER WELL DRILLERS LOG

7-17-72 19 date well completed  
 Jumper Well Drilling firm name  
 Tippah county well located

LANDOWNER:

Otis (L.C.) Rutherford  
 Rt # 2, Myrtle, Miss -  
 (mailing address)

description of formations encountered

from to

Sand & clay 0 100  
 Clay 100 200  
 Sand & rock 200 350

WELL LOCATION:

sec. 1 T 4 N R 3 E  
 1 miles So. of Myrtle  
 (distance) (direction) (nearest town)

WELL PURPOSE: home  
 (home, irrigation, municipal, industrial)

WELL COMPLETION DATA:

- (1) diameter (inches) 4"
- (2) total depth (feet) 350ft -
- (3) static water level (feet) 140 below top of ground.
- (4) casing PVC 150  
 (material) (depth)
- if telescope see back.
- (5) screen 0 0  
 (length) (depth to top)
- (size) (material)
- (6) pump 1 1/2 7  
 (HP) (yield gpm)
- Elec  
 (type power)
- (7) electric log NO  
 (yes or no)
- (organization running log)
- (8) how well bottom plugged 0

**CODED**


DEC 11 1972

MISS. BD. OF WATER COMMISSIONERS

DRILLERS REMARKS:

If well telescopes please sketch and show depths.

GROUND LEVEL

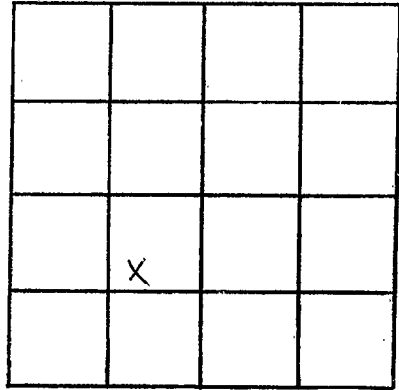

SECTION 1

Please indicate well location X.

ADDITIONAL INFORMATION

A series of 18 horizontal lines for writing additional information.

If more than one screen, show locations of each on sketch.