

TIPPAH  
J50  
2-5-73

MISSISSIPPI  
BOARD OF WATER COMMISSIONERS  
416 North State Street  
Jackson, Mississippi 39201

**CODED**

650.00  
3250  
62250

WATER WELL DRILLERS LOG

2-5-1973  
date well completed

JT Medlin  
firm name

Tippah  
county well located

LANDOWNER: <u>Joe Street</u> <u>Ripley</u> (mailing address)	description of formations encountered	from	to
	<u>clay</u>	<u>0</u>	<u>168</u>
	<u>rock &amp; sand</u>	<u>168</u>	<u>270</u>
<b>WELL LOCATION:</b>			
sec. <u>12</u> T. <u>4</u> N. R. <u>3</u> E.			
<u>4</u> miles <u>W</u> of <u>Ripley</u>			
(distance) (direction) (nearest town)			
<b>WELL PURPOSE:</b> (home, irrigation, municipal, industrial)			
<b>WELL COMPLETION DATA:</b>			
(1) diameter (inches) <u>4</u>			
(2) total depth (feet) <u>270</u>			
(3) static water level (feet) <u>66</u> below above top of ground.			
(4) casing <u>P</u> <u>105</u> (material) (depth)			
(size) if telescope see back.			
(5) screen <u>0</u> (length) (depth to top)			
(size) (material)			
(6) pump <u>1</u> <u>6</u> (HP) (yield gpm)			
<u>E</u> (type power)			
(7) electric log <u>yes or no</u>			
(organization running log)			
(8) how well bottom plugged			


**CODED**

MAR 5 1973

DRILLERS REMARKS:

If well telescopes please sketch and show depths.

GROUND LEVEL

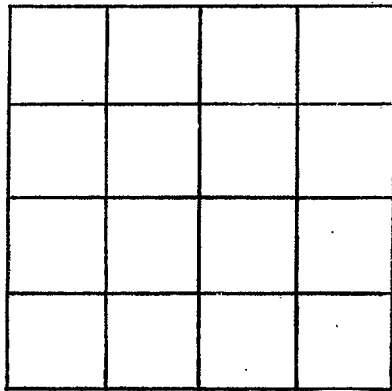

SECTION \_\_\_\_\_

Please indicate well location X.

ADDITIONAL INFORMATION

If more than one screen,  
show locations of each on sketch.