

TIPPAH  
 J 51  
 4-11-73

MISSISSIPPI  
 BOARD OF WATER COMMISSIONERS  
 416 North State Street  
 Jackson, Mississippi 39201

CODED 20.00  
 36.00  
 736.00

WATER WELL DRILLERS LOG

4 11 19 73  
 date well completed

J T Medlin  
 firm name

Tippah  
 county well located

LANDOWNER:

Robert Barkley  
 Ripley  
 (mailing address)

description of formations encountered

Clay  
 blue  
 rock & sand

from

to

0 27  
 27 250  
 250 340

WELL LOCATION:

sec. 15 T 4 N R 3 E  
 5 miles W of Ripley  
 (distance) (direction) (nearest town)

WELL PURPOSE:

(home, irrigation, municipal, industrial)

WELL COMPLETION DATA:

- (1) diameter (inches) 4
- (2) total depth (feet) 340
- (3) static water level (feet) 110 below top of ground.
- (4) casing P 120 (material) (depth)
- (size) If telescope see back.
- (5) screen (length) (depth to top)
- (size) (material)
- (6) pump 2 6 (HP) (yield gpm)
- E (type power)
- (7) electric log (yes or no)
- (organization running log)
- (8) how well bottom plugged

CODED


MISSISSIPPI BOARD OF WATER COMMISSIONERS

DRILLERS REMARKS:

10 OF

If well telescopes please sketch and show depths.

GROUND LEVEL

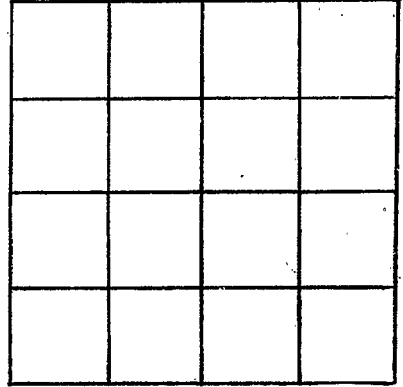

SECTION \_\_\_\_\_

Please indicate well location X.

ADDITIONAL INFORMATION

If more than one screen,  
show locations of each on sketch.