

TIPPAH  
J52  
3-11-73

MISSISSIPPI  
BOARD OF WATER COMMISSIONERS  
416 North State Street  
Jackson, Mississippi 39201

600.00  
600.00  
63000

WATER WELL DRILLERS LOG

3 11 19 73 JT Medlin Tippah  
date well completed firm name county well located

LANDOWNER:	description of formations encountered	from	to
Thomas Rodgers	clay	0	12
Blue water	rock & clay	12	45
(mailing address)	blue "	45	112
	rock & sand	112	170

WELL LOCATION:  
sec. 28 T 4 N R 3 E  
2 1/2 miles N of Blue water  
(distance) (direction) (nearest town)

WELL PURPOSE:  
(home, irrigation, municipal, industrial)

WELL COMPLETION DATA:

- diameter (inches) 4
- total depth (feet) 170
- static water level (feet) 22 below top of ground
- casing (material) P (depth) 70  
(size) if telescope see back.
- screen (length) (depth to top)  
(size) (material)
- pump 3/4 (HP) 6 (yield gpm)  
(type power) E
- electric log (yes or no)
- (organization running log)
- how well bottom plugged

CODED


BOARD OF WATER COMMISSIONERS

DRILLERS REMARKS:

ADVIS. SEC. 17

If well telescopes please sketch and show depths.

GROUND LEVEL

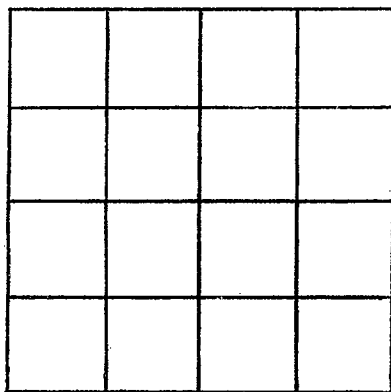

SECTION \_\_\_\_\_

Please indicate well location X.

ADDITIONAL INFORMATION

If more than one screen, show locations of each on sketch.