

TIPPAH
J 53
3-9-73

MISSISSIPPI
BOARD OF WATER COMMISSIONERS
416 North State Street
Jackson, Mississippi 39201

700.00
to 36.00
735.00
CODED

WATER WELL DRILLERS LOG

39 23 J. T. Medina Tippah
date well completed 19 firm name county well located

LANDOWNER:	description of formations encountered	from	to
Bonnie Holiday	clay	0	17
Rupley	Rock & clay	17	63
(mailing address)	Blue	65	80
	Rock & sand	80	100

WELL LOCATION:
sec. 20 T 4 N R 3 E
3 miles N of Blue Mtn.
(distance) (direction) (nearest town)

WELL PURPOSE:
(home, irrigation, municipal, industrial)

- WELL COMPLETION DATA:
- (1) diameter (inches) 4
 - (2) total depth (feet) 160
 - (3) static water level (feet) 12 below above top of ground.
 - (4) casing (material) P (depth) 60
If telescope see back. (size)
 - (5) screen (length) (depth to top) (size) (material)
 - (6) pump 1/2 (HP) 6 (yield gpm) (type power)
 - (7) electric log (yes or no) (organization running log)
 - (8) how well bottom plugged


CODED

MAR 11 1973

DRILLERS REMARKS:

If well telescopes please sketch and show depths.

GROUND LEVEL

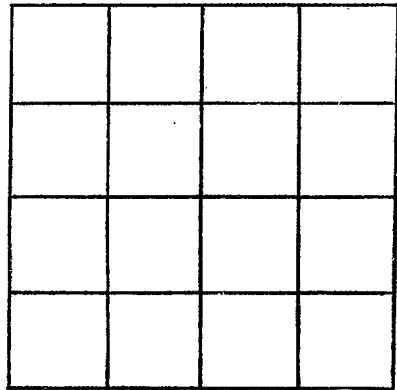

SECTION _____

Please indicate well location X.

ADDITIONAL INFORMATION

If more than one screen, show locations of each on sketch.