

TIPPAH
 J 54
 5-19-73

MISSISSIPPI
 BOARD OF WATER COMMISSIONERS
 416 North State Street
 Jackson, Mississippi 39201

650.00
 Tax 3250
 8250

CODED

WATER WELL DRILLERS LOG

5-19-1973 date well completed
 J T Medlin firm name
 Tippah county well located

LANDOWNER:
 Charles Brown
 Ripley
 (mailing address)

description of formations encountered
 clay
 rock
 from 0 to 175
 175 to 260

WELL LOCATION:
 sec. 17 T 9 N R 3 E
 S W
 (distance) miles (direction) of (nearest town)

WELL PURPOSE:
 (home, irrigation, municipal, industrial)

CODED


WELL COMPLETION DATA:
 (1) diameter (inches) 4
 (2) total depth (feet) 260
 (3) static water level (feet) 60 below top of ground
 (4) casing (material) P (depth) 70
 (size) if telescope see back.
 (5) screen (length) (depth to top)
 (size) (material)
 (6) pump (HP) 3/4 (yield gpm) 6
 (type power)
 (7) electric log (yes or no)
 (organization running log)
 (8) how well bottom plugged

DRILLERS REMARKS:

JUN 18 1973

If well telescopes please
sketch and show depths.

GROUND LEVEL

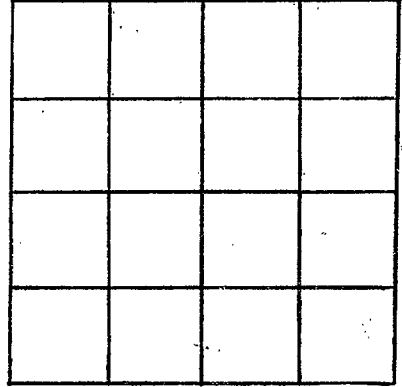

SECTION _____

Please indicate well location X.

ADDITIONAL INFORMATION

If more than one screen,
show locations of each on sketch.