

TIPPAN
J55
6-4-73

MISSISSIPPI
BOARD OF WATER COMMISSIONERS
416 North State Street
Jackson, Mississippi 39201

CODED 90.00
34.50
724.30

WATER WELL DRILLERS LOG

6-4-73 1973 J T Medlin Tippah
date well completed firm name county/well located

LANDOWNER: Don Woods
Ripley
(mailing address)

description of formations encountered	from	to
red clay	0	18
blue	18	70
rock & sand	70	165

WELL LOCATION:
sec. 24 T. 4 N. R. 3 E
2 miles E of Ripley
(distance) (direction) (nearest town)

WELL PURPOSE:
(home, irrigation, municipal, industrial)

- WELL COMPLETION DATA:
- (1) diameter (inches) 4
 - (2) total depth (feet) 165
 - (3) static water level (feet) 70 below top of ground.
 - (4) casing (material) P (depth) 70
 - (size) if telescope see back.
 - (5) screen (length) (depth to top)
 - (size) (material)
 - (6) pump 1 (HP) 5 (yield gpm)
 - (type power)
 - (7) electric log (yes or no)
 - (organization running log)
 - (8) how well bottom plugged


CODED

DRILLERS REMARKS:

JUL 23 1973

If well telescopes please sketch and show depths.

GROUND LEVEL

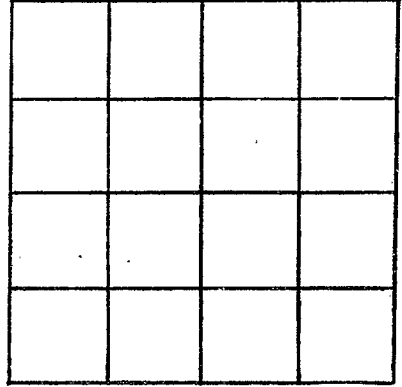

SECTION _____

Please indicate well location X.

ADDITIONAL INFORMATION

If more than one screen,
show locations of each on sketch.