

J 56  
 TIPPAH  
 7-21-73

MISSISSIPPI  
 BOARD OF WATER COMMISSIONERS  
 416 North ~~State~~ Street  
 Jackson, Mississippi 39201

900.00  
 450.00  
 745.00  
 Tippah  
 P. L. V.  
~~...~~

WATER WELL DRILLERS LOG

7 21 19 73 date well completed

J T Medlin firm name

Tippah county well located

LANDOWNER:

James Sullivan

description of formations encountered

Clay

from

to

954 Brown Memphis Tenn  
 (mailing address) 38111

Shale

0

3.2

CRK & Sand

32

183

183

360

WELL LOCATION:

sec. 16 T. 4 S. R. 3 E.  
 5 miles W of Poplar  
 (distance) (direction) (nearest town)

CODED

WELL PURPOSE:

(home, irrigation, municipal, industrial)

WELL COMPLETION DATA:

(1) diameter (inches) 3.60 4

(2) total depth (feet) 360

(3) static water level (feet) 85 below above top of ground.

(4) casing R 100 (material) (depth)

(size) if telescope see back.

(5) screen 0 (length) (depth to top)

(size) (material)

(6) pump 5 6 (HP) (yield gpm)

(type power)

(7) electric log (yes or no)

(organization running log)


(8) how well bottom plugged

AUG 22 1973

DRILLERS REMARKS:

If well telescopes please sketch and show depths.

GROUND LEVEL

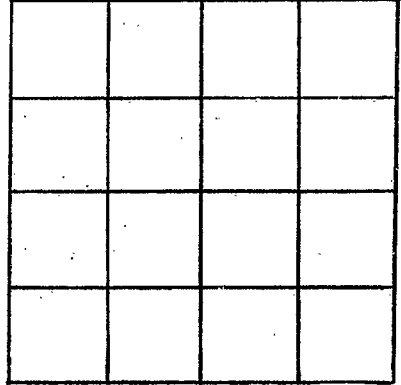

SECTION \_\_\_\_\_

Please indicate well location X.

ADDITIONAL INFORMATION

If more than one screen,  
show locations of each on sketch.