

TIPPAN
 J 60
 4-24-74

MISSISSIPPI
 BOARD OF WATER COMMISSIONERS
 416 North State Street
 Jackson, Mississippi 39201

CODED

WATER WELL DRILLERS LOG

APR 24 1974 Billy R. Simpson TIPPAN
 date well completed firm name county well located

LANDOWNER:
J.C. ALLEN
Ripley Miss
 (mailing address)

description of formations encountered	from	to
SEAPSTONE CLAY	0	26
SAND	26	28
ROCK	28	30
Blue CLAY	30	38
Rock + SAND	38	70
Blue CLAY	70	127
Rock + SAND	127	170
Blue CLAY	170	195
ROCK + SAND	195	233

WELL LOCATION:
 sec 27 T 4 S R 3 E
1 miles SW of Ripley
 (distance) (direction) (nearest town)

WELL PURPOSE: HOME
 (home, irrigation, municipal, industrial)

- WELL COMPLETION DATA:
- (1) diameter (inches) 4
 - (2) total depth (feet) 233
 - (3) static water level (feet) 36 below top of ground.
 - (4) casing POC 76
 (material) (depth)
 _____ if telescope see back.
 (size)
 - (5) screen None
 (length) (depth to top)

 (size) _____ (material)
 (6) pump 1/2 4
 (HP) (yield gpm)
Elec
 (type power)
 - (7) electric log NO
 (yes or no)

 (organization running log)
 - (8) how well bottom plugged _____

CODED


RECEIVED
 APR 26 1974

DRILLERS REMARKS:

MISS. Bd. OF WATER COMMISSIONERS

If well telescopes please sketch and show depths.

GROUND LEVEL

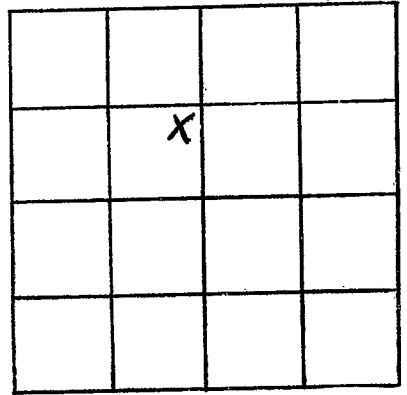

SECTION 27

Please indicate well location X.

ADDITIONAL INFORMATION

If more than one screen, show locations of each on sketch.

A handwritten scribble or signature at the bottom right of the page.