

TIPPAAH
 J61
 3-3-74

MISSISSIPPI CODED
 BOARD OF WATER COMMISSIONERS
 416 North State Street
 Jackson, Mississippi 39201

WATER WELL DRILLERS LOG

#3-3 1974 J.T. Medlin Tippaah
 date well completed firm name county well located

LANDOWNER: Ford Smith
Ripley HW 15 S
 (mailing address)

| description of formations encountered | from | to |
|---------------------------------------|------|-----|
| Red clay | 0 | 12 |
| Rock + clay | 12 | 60 |
| blue " | 60 | 120 |
| Rock + sand | 120 | 200 |

WELL LOCATION:
 sec 27 T T N 3 E
3 miles S of Ripley
 (distance) (direction) (nearest town)

WELL PURPOSE:
 (home, irrigation, municipal, industrial)

- WELL COMPLETION DATA:
- (1) diameter (inches) 4
- (2) total depth (feet) 200
- (3) static water level (feet) 18 below above top of ground.
- (4) casing P 80
 (material) (depth)
- If telescope see back.
 (size)
- (5) screen
 (length) (depth to top)
- (size) (material)
- (6) pump 1/2 12
 (HP) (yield gpm)
- E
 (type power)
- (7) electric log
 (yes or no)
- (organization running log)
- (8) how well bottom plugged


CODED

RECEIVED
 AUG 15 1974

DRILLERS REMARKS:

If well telescopes please sketch and show depths.

GROUND LEVEL

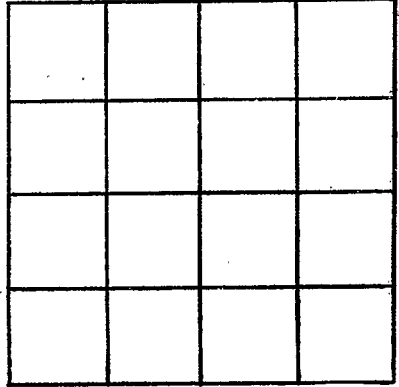

SECTION _____

Please indicate well location X.

ADDITIONAL INFORMATION

If more than one screen,
show locations of each on sketch.