

CODED

TIPPAN
562
4-27-74
4

MISSISSIPPI
BOARD OF WATER COMMISSIONERS
416 North State Street
Jackson, Mississippi 39201

WATER WELL DRILLERS LOG

date well completed 4-27-74 firm name J.T. Medley Tippah county well located

LANDOWNER: Walter Johnson
Ripley 38652
(mailing address)

description of formations encountered	from	to
Clay	0	18
rock & sand	18	760

WELL LOCATION:
sec. 19 T. 4 N. R. 3E
42 miles 160 of Ripley
(distance) (direction) (nearest town)

WELL PURPOSE:
(home, irrigation, municipal, industrial)

- WELL COMPLETION DATA:
- (1) diameter (inches) 4
 - (2) total depth (feet) 160
 - (3) static water level (feet) 40 below above top of ground.
 - (4) casing P 160
(material) (depth)
 - _____ if telescope see back.
(size)
 - (5) screen 10 150
(length) (depth to top)
 - 4 P
(size) (material)
 - (6) pump 1/2 16
(HP) (yield gpm)
 - E
(type power)
 - (7) electric log _____
(yes or no)
 - _____ (organization running log)

CODED

(8) how well bottom plugged Open


DRILLERS REMARKS:

RECEIVED
AUG 15 1974

MISS. BD. OF WATER

If well telescopes please
sketch and show depths.

GROUND LEVEL

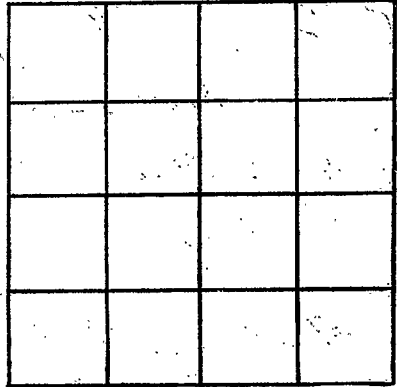

SECTION _____

Please indicate well location X.

ADDITIONAL INFORMATION

If more than one screen,
show locations of each on sketch.