

TIPPAN
JL3
7-18-79

MISSISSIPPI
BOARD OF WATER COMMISSIONERS
416 North State Street
Jackson, Mississippi 39201

700.00
CODED

WATER WELL DRILLERS LOG


7-18-1979 date well completed
J.T. Medlin firm name
Tippah county well located

LANDOWNER: <u>New Church</u>	description of formations encountered	from	to
<u>Blue Mt</u>			
	<u>Sand rock</u>	<u>30</u>	<u>120</u>
(mailing address)			
WELL LOCATION: sec. <u>36</u> T. <u>4</u> N. R. <u>3</u> E. S. W.			
(distance) _____ miles _____ of _____ (direction) _____ (nearest town)			
WELL PURPOSE: (home, irrigation, municipal, industrial)			
WELL COMPLETION DATA:			
(1) diameter (inches) <u>4</u>			
(2) total depth (feet) <u>180</u>			
(3) static water level (feet) <u>60</u> below/above top of ground.			
(4) casing <u>R</u> (material) <u>60</u> (depth)			
_____ (size) If telescope see back.			
(5) screen <u>Ø</u> (length) _____ (depth to top)			
_____ (size) _____ (material)			
(6) pump <u>1/2</u> (HP) <u>10</u> (yield gpm)			
<u>E</u> (type power)			
(7) electric log _____ (yes or no)			
_____ (organization running log)			
(8) how well bottom plugged _____			
DRILLERS REMARKS:			

RECEIVED
SEP - 5 1979

If well telescopes please sketch and show depths.

GROUND LEVEL

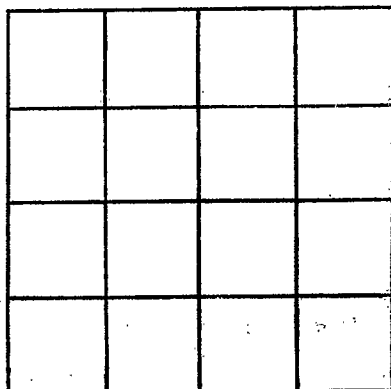

SECTION _____

Please indicate well location X.

ADDITIONAL INFORMATION

If more than one screen, show locations of each on sketch.