

TIPPAN  
 564  
 8/27-74

MISSISSIPPI  
 BOARD OF WATER COMMISSIONERS  
 416 North State Street  
 Jackson, Mississippi 39201

CODED

WATER WELL DRILLERS LOG

Aug 27 1974 Billy R. Simpson TIPPAN  
 date well completed firm name county well located

LANDOWNER:  
 LEE CREIGHTON  
 Ripley Ms.  
 (mailing address)

description of formations encountered	from	to
SALT AND CLAY	0	16
SAND	16	20
BLUE CLAY	20	62
LIME STONE + SAND	62	130
Blue CLAY	130	160
LIME STONE + SAND	160	189
Blue CLAY	189	194

WELL LOCATION:  
 sec 20 T 4 N R 3 E  
 4 miles W of Ripley  
 (distance) (direction) (nearest town)

WELL PURPOSE: Home  
 (home, irrigation, municipal, industrial)

WELL COMPLETION DATA:

(1) diameter (inches) 4

(2) total depth (feet) 194

(3) static water level (feet) 1 below top of ground

(4) casing PVC 60 (material) (depth)

(size) if telescope see back.

(5) screen None (length) (depth to top)

(size) (material)

(6) pump 1/2 7 (HP) (yield gpm)

Electric (type power)

(7) electric log No (yes or no)

(organization running log)


(8) how well bottom plugged

DRILLERS REMARKS:

RECEIVED  
 SEP 20 1974

If well telescopes please sketch and show depths.

GROUND LEVEL

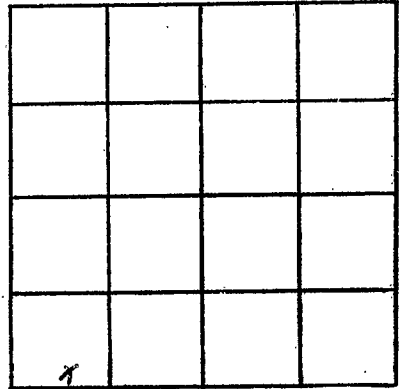

SECTION 20

Please indicate well location X.

ADDITIONAL INFORMATION

If more than one screen, show locations of each on sketch.