

TIPPAN  
~~11-7-74~~  
 11-7-74

MISSISSIPPI  
 BOARD OF WATER COMMISSIONERS  
 416 North State Street  
 Jackson, Mississippi 39201

CODED

WATER WELL DRILLERS LOG

Nov 7 1974 Billy R. Simpson TIPPAN  
 date well completed firm name county well located

LANDOWNER:  
TRICE HUGHES  
RIPLEY MISS  
 (mailing address)

description of formations encountered	from	to
SURFACE CLAY	0	15
SAND	15	45
WHITE CLAY & SAND	45	80
ROCK	80	81
Blue CLAY	81	271
ROCK	271	272
CLAY & SAND	272	282
LIMESTONE & SAND	282	353
Blue CLAY	353	370
LIMESTONE & SAND	370	404

WELL LOCATION:  
 sec. 1 T 4 N R 3 E  
                   S                  W  
8 miles W of RIPLEY  
 (distance) (direction) (nearest town)

WELL PURPOSE: HOUS  
 (home, irrigation, municipal, industrial)

- WELL COMPLETION DATA:
- (1) diameter (inches) 4
  - (2) total depth (feet) 404
  - (3) static water level (feet) 129 below above top of ground.
  - (4) casing POC, 177,  
 (material) (depth)
  - (size) If telescope see back.
  - (5) screen NO PC  
 (length) (depth to top)
  - (size) (material)
  - (6) pump 3/4 10  
 (HP) (yield gpm)
  - FLCC  
 (type power)
  - (7) electric log NO  
 (yes or no)
  - (organization running log)
  - (8) how well bottom plugged


DRILLERS REMARKS:

CODED

REGISTERED  
 DEC 9 1974  
 MISS. Bd. OF WATER COMMISSIONERS

If well telescopes please  
sketch and show depths.

GROUND LEVEL

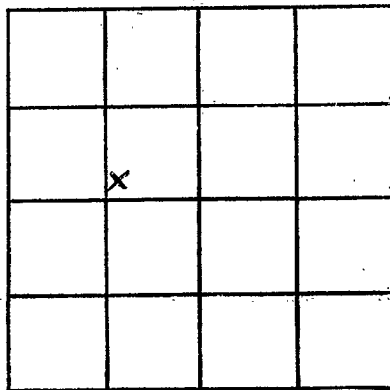

SECTION     

Please indicate well location X.

ADDITIONAL INFORMATION

If more than one screen,  
show locations of each on sketch.