

Tippah
 J 6 18
 7-14-75

MISSISSIPPI
 BOARD OF WATER COMMISSIONERS
 416 North State Street
 Jackson, Mississippi 39201

CODED

WATER WELL DRILLERS LOG

7 14 19 75 *J F Maddox* Tippah
 date well completed firm name county well located

LANDOWNER: *J F Maddox*
Ripley Curtis
 (mailing address)

description of formations encountered	from	to
<i>Clay</i>	<i>0</i>	<i>125</i>
<i>Shale & Sand</i>	<i>125</i>	<i>260</i>

WELL LOCATION:
 sec *16* T *4* N R *3* E *15F*
3 miles *West* of *Ripley*
 (distance) (direction) (nearest town)

CODED

WELL PURPOSE:
 (home, irrigation, municipal, industrial)

WELL COMPLETION DATA:


(1) diameter (inches) *4*
 (2) total depth (feet) *260*
 (3) static water level (feet) *50* below above top of ground.
 (4) casing *P* *100*
 (material) (depth)
 (size) if telescope see back.
 (5) screen (length) (depth to top)
 (size) (material)
 (6) pump *3/4* *6*
 (HP) (yield gpm)
 (type power)
 (7) electric log (yes or no)
 (organization running log)
 (8) how well bottom plugged

DRILLERS REMARKS:

RECEIVED
 AUG 17 1975

If well telescopes please sketch and show depths.

GROUND LEVEL

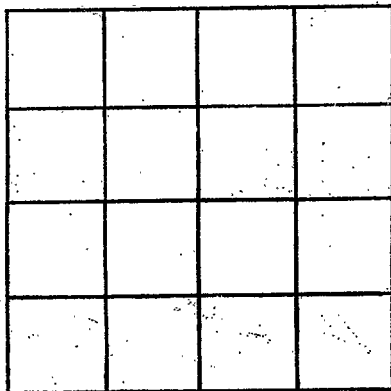

SECTION _____

Please indicate well location X.

ADDITIONAL INFORMATION

If more than one screen,
show locations of each on sketch.