

TIPPAH  
J 70  
9-18-75

MISSISSIPPI  
BOARD OF WATER COMMISSIONERS  
416 North State Street  
Jackson, Mississippi 39201

WATER WELL DRILLERS LOG

Sept. 18 1975 J.T. Modlin Tippah  
date well completed firm name county well located

LANDOWNER:  
Jerry Haynes  
Ripley  
(mailing address)

description of formations encountered	from	to
	Shale & Clay	0

WELL LOCATION:  
sec. 7 T. 4 N. R. 3 E.  
4 miles NE of Ripley  
(distance) (direction) (nearest town)

Clay	60	310
SAND & ROCK	310	360

WELL PURPOSE:  
(home, irrigation, municipal, industrial)

WELL COMPLETION DATA:

(1) diameter (inches) 4

(2) total depth (feet) 360 ft.

(3) static water level (feet) \_\_\_\_\_ below above top of ground.

(4) casing 4" 130 ft.  
(material) (depth)

\_\_\_\_\_ if telescope see back.  
(size)

(5) screen \_\_\_\_\_  
(length) (depth to top)

\_\_\_\_\_ (size) \_\_\_\_\_ (material)

(6) pump 1/2 8  
(HP) (yield gpm)

\_\_\_\_\_ (type power)

(7) electric log \_\_\_\_\_  
(yes or no)

\_\_\_\_\_ (organization running log)

(8) how well bottom plugged \_\_\_\_\_


take left 3  
miles north of  
Ripley on  
gravel road

DRILLERS REMARKS:

DECEMBER 1975

If well telescopes please sketch and show depths.

GROUND LEVEL

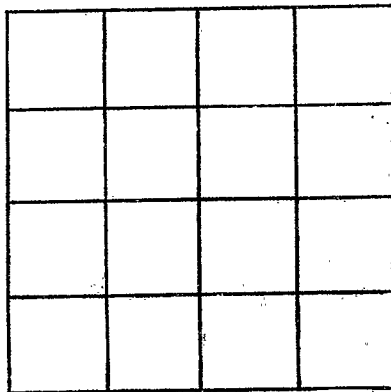

SECTION \_\_\_\_\_

Please indicate well location X.

ADDITIONAL INFORMATION

If more than one screen, show locations of each on sketch.