

TIPPAA
 571
 9-20-75

MISSISSIPPI
 BOARD OF WATER COMMISSIONERS
 416 North State Street
 Jackson, Mississippi 39201

WATER WELL DRILLERS LOG

Sept. 20 1975 J.T. Meekin Tippah
 date well completed firm name county well located

LANDOWNER:
 DAVID KENT
 1714 N. W. 1714 N. W.
 (mailing address)

description of formations encountered from to
 CIM 0 100

WELL LOCATION:
 sec. 3 T4 N R3 E
 3 miles W of Blue Ridge
 (distance) (direction) (nearest town)

FOCK SAND 100 200

WELL PURPOSE:
 (home, irrigation, municipal, industrial)

WELL COMPLETION DATA:
 (1) diameter (inches) 4
 (2) total depth (feet) 270 ft
 (3) static water level (feet) 10' below top of ground.
 (4) casing 90 ft (material) (depth)
 (size) if telescope see back:
 (5) screen (length) (depth to top)
 (size) (material)
 (6) pump 1/2 (HP) 7 (yield gpm)
 E (type power)
 (7) electric log (yes or no)
 (organization running log)
 (8) how well bottom plugged


Palmer Tube

DRILLERS REMARKS:

MISSISSIPPI
 BOARD OF WATER COMMISSIONERS
 OCT 16 1975

If well telescopes please
sketch and show depths.

GROUND LEVEL

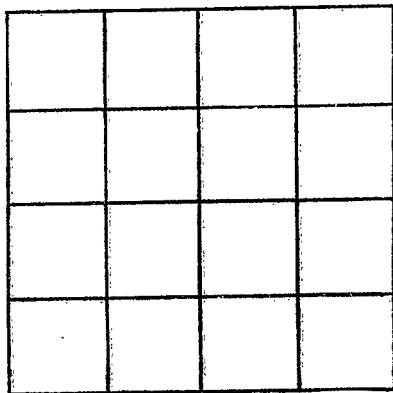

SECTION _____

Please indicate well location X.

ADDITIONAL INFORMATION

If more than one screen,
show locations of each on sketch.