

MISSISSIPPI DEPARTMENT OF NATURAL RESOURCES

Bureau of Land and Water Resources

P.O. Box 10631
Jackson, Mississippi 39209
WATER WELL DRILLERS LOG

COUNTY WELL LOCATED TIPPAN		
WELL NUMBER 576	CODED CODED	PERMIT NUMBER
NAME OF DRILLING FIRM J. W. WEBB & SONS		
DATE WELL COMPLETED JUNE 1987		
INC. INC.		

NAME & MAILING ADDRESS OF LANDOWNER CITY OF RIPLEY			
RIPLEY, MS			
WELL LOCATION: SEC TOWNSHIP RANGE			
14	H	S	3
DISTANCE DIRECTION NEAREST TOWN			
1/2 Miles	W of	RIPLEY	
OTHER LANDMARK			
WELL PURPOSE: Home, Irrigation, <u>Municipal</u> , Industrial, Fish Pond, etc.			

PUMP DATA		
PUMP TYPE (Circle One): Submersible, <u>Turbine</u> , Jet Flowing Well, Other (Describe) _____		
POWER TYPE (Circle One): <u>Electric</u> , Tractor, Diesel, Gasoline, Butane, Other (Describe) _____		
Pump Capacity (GPM) 350	No. of Stages 13	Setting Depth 500 FT.
PUMP TEST		
Well yielded 350 GPM with a drawdown of 230 ft. after 24 hours of pumping		

WELL DATA		
Well Depth 928	Casing Diameter (In.) 12"	Casing Length (Ft.) 860
Type of Casing STEEL	Hole Depth 220	Depth to Static Water Level
TYPE OF COMPLETION: (Circle One or More): <u>Gravel Packed</u> , <u>Underreamed</u> , Telescoped, Natural Development, Open Hole, Other		
Top of Lap Pipe or Reduction in Casing 788 FEET		
IF TELESCOPED OR MORE THAN ONE SCREEN: USE BACK PAGE		

LOG DATA	
TYPE OF LOG RUN (Circle One): No Log Run, <u>Electric</u> , Gamma Ray, Density, Sonic, Neutron, Other (Describe) _____	
Name of Organization Running Log STATE	


SCREEN DATA		
Diameter - Inches 8	Length - Feet 60	Slot Size - Inches .030
Screen Type S.S.		Depth to Bottom - Feet 928

GEOLOGIC DATA (Office Use Only)			
Surface Elev.	Geologic Unit	Unit Thickness	Depth to Top
Subs. SWL	Date	Analysis	Aquifer Test
Driller's Remarks <div style="text-align: center; font-size: 2em; font-weight: bold; opacity: 0.5;">RECEIVED</div> OCT 15 1987			

DESCRIPTION OF FORMATIONS ENCOUNTERED	FROM	TO	FORMATIONS (Continued)
CLAY	0	20	Department of Natural Resources Bureau of Land & Water Resources
SAND	20	60	
CLAY	60	110	
SAND & ROCK	110	260	
CLAY	260	800	
SAND	800	920	
CLAY & SAND	920	975	
IF MORE SPACE IS NEEDED, USE BACK			

If well telescopes please sketch and show depths.

GROUND LEVEL

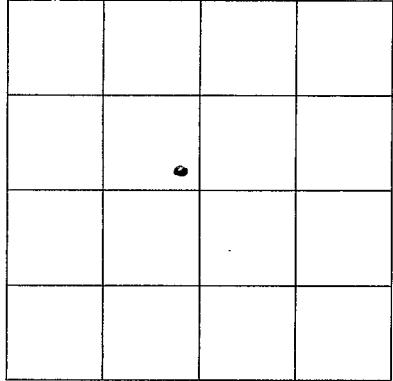

SECTION 124

Please indicate well location X.

ADDITIONAL INFORMATION

Lined area for additional information.

If more than one screen, show location of each on sketch.