

County: Tippah ✓  
 Permit #: GW 17329  
 Driller: Parks & Parks  
 Date drilling completed: 7/14/17

**State Well Report**  
**Part 1 – Driller's Log**  
 Mississippi Department of Environmental Quality  
 Office of Land and Water Resources  
 P.O. Box 10631  
 Jackson, MS 39289-0631  
 (601)961-5210  
 (601)354-6938 (fax)

For Office Use Only:

Aquifer: \_\_\_\_\_  
 Well #: 580  
 L. S. Elevation: \_\_\_\_\_  
 E-log #: \_\_\_\_\_

*State Law requires that this report be prepared by the license holder responsible for the work and filed with the Department at the above address within 30 days of completion of drilling of the well or borehole.*

Information on Well Owner <i>(Landowner if borehole is not for a water well)</i>	Well or Borehole Location
Owner Name: <u>Oil Dry Dri Prod. Co.</u>	Latitude: <u>34° 25' 3.997"</u> Longitude: <u>88° 43' 8.980"</u> <u>34-45-14</u> <u>88-56-20</u>
Mailing Address: <u>P.O. Box 476</u> <u>Ripley, MS 38663</u>	Method of Lat/Long (circle one): <u>Conventional Survey</u>
City: _____ State: _____ Zip Code: _____	USGS quad, Hand-held GPS, Survey-grade GPS
Telephone No. <u>(662) 316-9505</u>	<u>NE 1/4 NW 1/4 Sec 12 Twn 4S Rng 3E</u>
	Distance _____ Direction _____ Nearest Town _____ Miles _____ of <u>Ripley, MS</u>

**Well / Borehole Data**

Date drilling started: JUNE 15, 2017 Date drilling completed: JULY 14, 2017 Hole depth: 260 Hole diameter: 12x8

Location of the source of any surface water used for drilling: \_\_\_\_\_  
 Method of dosing and volume of Chlorine used in drilling and development: \_\_\_\_\_

Logs run (circle all applicable) No log run Electric Gamma Ray Density Sonic Neutron Other: \_\_\_\_\_  
 Name of organization running log(s): \_\_\_\_\_

Purpose of borehole (check one): Water Well  Geotechnical/Geological Investigation \_\_\_\_\_ Ground Source Heat Pump \_\_\_\_\_  
 Seismic Survey \_\_\_\_\_ Other (describe) \_\_\_\_\_

*If drilling is not related to water well construction, skip the remainder of this block*

Purpose of Well (check one): Home \_\_\_\_\_ Industrial  Public Supply \_\_\_\_\_ Irrigation \_\_\_\_\_ Fish Culture \_\_\_\_\_ Other: \_\_\_\_\_

If a flowing well, method of flow regulation: Valve \_\_\_\_\_ Other (describe) \_\_\_\_\_

Static Water Level: 90 feet above or below (circle one) land surface Date measured: 7/24/17

Method of Measurement (circle one) steel tape electric tape air line other: \_\_\_\_\_

Well depth: 260 Well grouted to a depth of 200 feet Type of grout (circle one) Neat Cement Bentonite Mix

Casing length: 200 feet Casing diameter: 12 inches Type of casing: Steel

Screen length: 50 feet Screen diameter: 8 inches Type of screen: Stainless Steel

Screen slot size: .020 inches Setting depth: From 210 feet to 260 feet

Type of completion (circle all applicable) Gravel packed Underreamed Telescoped Open hole Natural Development  
 Other (describe): \_\_\_\_\_

Top of lap pipe or reduction in casing: 170 feet. *If telescoped or more than one screen, describe on next page*


**RECEIVED**  
**JUL 31 2017**  
**BY OLWR**

County: Tippah  
 Permit #: \_\_\_\_\_

**For Office Use Only:**  
 Well #: J80

The sketch below only required for water wells

If well telescopes, show depths on sketch.

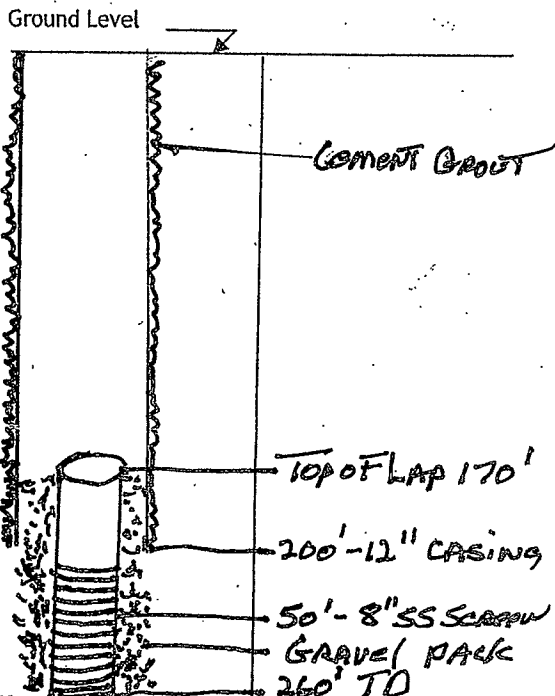

If more than one screen, show location of each on sketch

Description of formations encountered must be provided for all wells and boreholes, unless specifically exempted by regulations

Description of Formations Encountered	From (depth)	To (depth)
	Ground level	
Clay Rock	0	20
Clay & Gravel Sand	20	40
Sandy Clay	40	100
Clay Rock Sand	100	130
Sand/Rocky	130	260

- Sketch the property layout and include the following:
- 1) the well location
  - 2) any permanent structures on the property that may aid in locating the well
  - 3) any roads, power lines, or other items that may aid in locating the property and the well
  - 4) north arrow

MAP ATTACHED

RECEIVED  
 JUL 31 2017  
 BY OLWR

Landowner Name: Oil Dry

I HEREBY CERTIFY that the well/borehole was drilled, constructed, and completed in accordance with all applicable requirements of the Mississippi Department of Environmental Quality and the Mississippi Department of Health regulations, if applicable, and state laws.

RANDY PATES 0-414      7/29/17      Randy Pates  
 Print Name of Responsible Licensee and License No.      Date      Signature of Licensee

# STATE WELL REPORT

## Part 2

**Pump Installer's Completion Report**  
 Mississippi Department of Environmental Quality  
 Office of Land and Water Resources  
 P.O. Box 2309  
 Jackson, MS 39225-2309  
 (601)961-5210  
 (601) 360-0535 (fax)

County: TIPPAN  
 Permit #: \_\_\_\_\_  
 Driller: Parks & Parks  
 Date completed: 7/14/17  
*Copy information from block on Part 1*

**For Office Use Only:**

Well #: J80  
 Aquifer: \_\_\_\_\_

*This part of the report must be completed by a licensed water well contractor or a licensed pump installer. A copy of Part 1 of the report must be attached and both parts filed with the Department at the above address within 30 days of well completion.*

Well Owner Information		Well Location	
Owner Name: <u>Oil Dry</u>		<u>34-45-14</u>	<u>88-56-20</u>
Mailing Address: <u>P.O. Box 476</u> <u>Ripley, MS 38663</u>		Latitude: <u>34.753897</u>	Longitude: <u>88.938980</u>
City: _____ State: _____ Zip Code: _____		Method of Lat/Long (check one): Conventional Survey _____, USGS quad _____, Hand-held GPS _____, Survey-grade GPS _____	
Telephone No. <u>(662) 316-9505</u>		<u>NE 1/4 NW 1/4, Sec 12 T 45 R 3E</u>	
		<u>Ripley</u> (Distance) _____ of _____ (Nearest Town)	

**Pump Type (circle one)**

Submersible    Turbine    Air Lift    Centrifugal    Flowing Well    Jet    Piston    Rotary    Other (describe): \_\_\_\_\_

Date Pump Installed: 7/24/17    Rated Pump Capacity: 300 Gallons Per Minute

Is This Pump (circle one):  New    Repaired    Replacement

**Power Type (circle one)**

Electric    Diesel    Gasoline    Natural Gas    Tractor PTO    Windmill    Other (describe): \_\_\_\_\_

Horse Power Rating of Motor: 30 HP    Setting Depth: 147 feet    Number of Stages: 8

**Pump Test Data for Non Flowing Well**

Date Well Tested: 7/24/17    Duration of Pump Test (minimum 4 hours): 4 hours

Static Water Level (A): 90 Feet Below Land Surface    Pumping Water Level (B): 120 Feet Below Land Surface

Drawdown [(B) - (A)]: 120 Feet Below Land Surface    Test Pumping Rate: 300 Gallons Per Minute

Method of measurement (circle one): Steel tape     Electric tape    Air line    Other (describe): \_\_\_\_\_

**Pump Test Data for Flowing Well**

Measured shut in head: 280 feet.

Well yielded 300 GPM with a drawdown of 30 feet after 4 hours of pumping

**Meter Installation**

Meter Manufacturer: \_\_\_\_\_    Meter Serial Number: \_\_\_\_\_

Meter Model Number/Name: \_\_\_\_\_    Type of Meter: \_\_\_\_\_

Totalizer Register Unit and Multiplier Factor (AF x .001, gal x 1000, etc): \_\_\_\_\_

Installation Date: \_\_\_\_\_    Meter installed by: Oil Dry

Is This Meter (circle one):  New    Repaired    Replacement

**RECEIVED**  
**JUL 31 2017**  
**BY OLWR**

*Important: By submitting the above information you are certifying that this meter was installed to manufacturer standards. For agricultural wells, a list of approved meters is on the MDEQ website.*


I HEREBY CERTIFY that the above statements are true to the best of my knowledge.

Ryan Parks 0-414    7/27/17    Ryan Parks  
 Print Name of Pump Installer and License No. (if applicable)    Date    Signature of Pump Installer

bing maps

Notes

OIL DRI  
 RIPLEY, MS  
 34.753897  
 88.938980

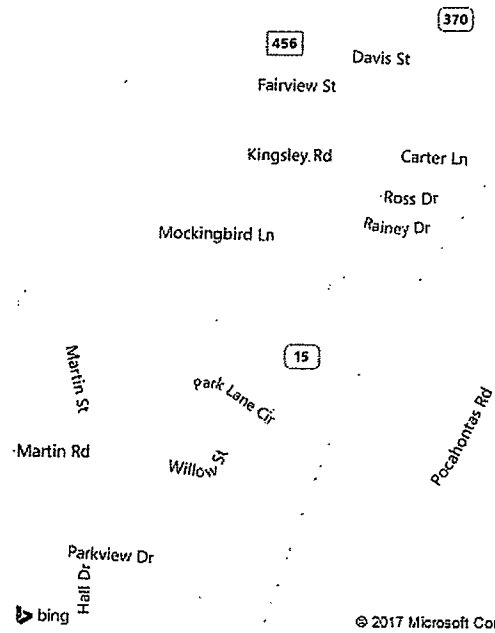

© 2017 Microsoft Corporation © 2017 HERE

