

Tippah
 T 2000
 12-66

MISSISSIPPI
 BOARD OF WATER COMMISSIONERS
 416 North State Street
 Jackson, Mississippi 39201

WATER WELL DRILLERS LOG

Dec 16 1966 date well completed
 666 Jumpers Well Co. firm name
 Tippah county well located

LANDOWNER:

Tippah Concrete Co.
 Ripley, Miss.
 (mailing address)

description of formations encountered

from to

WELL LOCATION:

sec. 27 T 45 N R 3 E
 S W
 2 miles South of Ripley
 (distance) (direction) (nearest town)

clay + rock 0 220

WELL PURPOSE:

(home, irrigation, municipal, industrial)
 residential

water, sand + rock 220 260

WELL COMPLETION DATA:

(1) diameter (inches) 5"
 (2) total depth (feet) 260'
 (3) static water level (feet) 2' below top of ground.

(4) casing pvc, 260'
 (material) (depth)
 5" (size) if telescope see back.

(5) screen 30', 220'
 (length) (depth to top)
 32 pvc + gravel
 (size) (material)

(6) pump 5 50
 (HP) (yield gpm)

electricity
 (type power)

(7) electric log no
 (yes or no)

(organization running log)


(8) how well bottom plugged pvc cap

DRILLERS REMARKS:



If well telescopes please sketch and show depths.

GROUND LEVEL

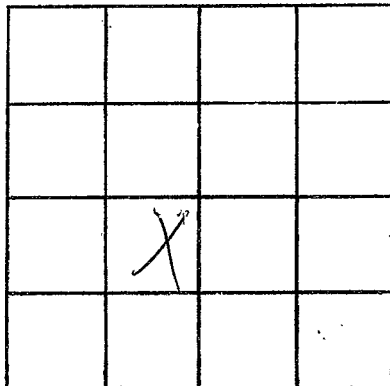

SECTION _____

Please indicate well location X.

ADDITIONAL INFORMATION

If more than one screen, show locations of each on sketch.