

TIPPANH
 J 2001
 4-14-76

MISSISSIPPI
 BOARD OF WATER COMMISSIONERS
 416 North State Street
 Jackson, Mississippi 39201

WATER WELL DRILLERS LOG

APRIL 14 1976 Billy R. Scarpson TIPPANH
 date well completed firm name county well located


LANDOWNER:	description of formations encountered	from	to
DAVID HARDIN	SURFACE CLAY	0	10
RIPLEY MISS.	YELLOW CLAY	10	18
(mailing address)	BLUE CLAY	18	27
	ROCK	27	36
WELL LOCATION:	LIMESTONE + SAND	36	46
sec. <u>36</u> T <u>4</u> R <u>3</u> E	SOFT LIMESTONE	46	60
<u>3</u> miles <u>S</u> of <u>RIPLEY</u>	BLUE CLAY	60	75
(distance) (direction) (nearest town)	ROCK + SAND	75	80
	BLUE CLAY	80	88
WELL PURPOSE: <u>HOME</u>	ROCK	88	89
(home, irrigation, municipal, industrial)	BLUE CLAY	89	102
WELL COMPLETION DATA:	ROCK + BLUE CLAY	102	112
(1) diameter (inches) <u>4</u>	LIMESTONE + SANDS	112	189
(2) total depth (feet) <u>191</u>	BLUE CLAY	189	191
(3) static water level (feet) <u>79</u> below above top of ground.			
(4) casing <u>POC</u> <u>96</u> (material) (depth)			
<u> </u> if telescope see back. (size)			
(5) screen <u>NOISE</u> (length) (depth to top)			
(size) (material)			
(6) pump <u>1/2</u> <u>10</u> (HP) (yield gpm)			
<u>Elec</u> (type power)			
(7) electric log <u>NO</u> (yes or no)			
(organization running log)			
(8) how well bottom plugged			
DRILLERS REMARKS:			

RECEIVED
 APR 20 1976

MISS. BD. OF WATER COMM.

If well telescopes please sketch and show depths.

GROUND LEVEL

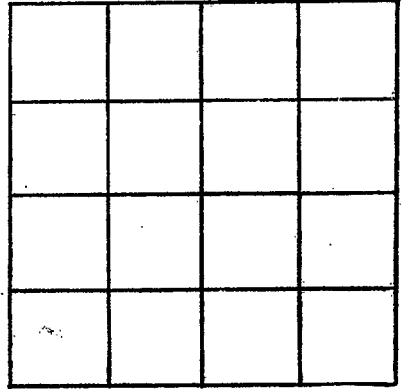

SECTION _____

Please indicate well location X.

ADDITIONAL INFORMATION

If more than one screen,
show locations of each on sketch.