

Tippah
J 2004
4-28-77

MISSISSIPPI
 BOARD OF WATER COMMISSIONERS
 416 North State Street
 Jackson, Mississippi 39201

WATER WELL DRILLERS LOG

APRIL 28
 date well completed

15F

Billy R. Simpson
 firm name

TIPPAH
 county well located

LANDOWNER:
JAMES HINSON
Ripley Miss
 (mailing address)

description of formations encountered	from	to
SURFACE CHALK	0	4
SOAPSTONE CLAY	4	20
SOAPSTONE + SAND	20	32
ROCK	32	33
BLUE CLAY	33	147
SAND	147	150
LIMESTONE	150	197
BLUE CLAY	197	238
LIMESTONE + SAND	238	331

WELL LOCATION:
 sec. 15 T. 4 N. R. 3 E.
1/2 miles W of Ripley
 (distance) (direction) (nearest town)

WELL PURPOSE: HOME
 (home, irrigation, municipal, industrial)


- WELL COMPLETION DATA:
- (1) diameter (inches) 4
 - (2) total depth (feet) 330
 - (3) static water level (feet) 142 below top of ground.
 - (4) casing POC (material), 150 (depth)
 - (size) if telescope see back.
 - (5) screen None (length), (depth to top)
 - (size) (material)
 - (6) pump 2 HP (HP), 10 (yield gpm)
 - Elec (type power)
 - (7) electric log NO (yes or no)
 - (organization running log)
 - (8) how well bottom plugged

DRILLERS REMARKS:

RECEIVED
 MAY 21 1977
 MISS. Bd. OF WATER COMMISSION

If well telescopes please sketch and show depths.

GROUND LEVEL

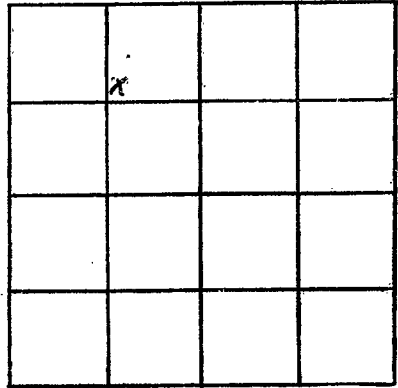

SECTION 15

Please indicate well location X.

ADDITIONAL INFORMATION

If more than one screen, show locations of each on sketch.