

TIPPAH
J 2005

MISSISSIPPI
BOARD OF WATER COMMISSIONERS
416 North State Street
Jackson, Mississippi 39201

WATER WELL DRILLERS LOG

3-6-78 19 Bryant's Well Drilling Tippah
date well completed firm name county well located

LANDOWNER:	description of formations encountered	from	to
J. T. Goshlin Blue Mtn Miss (mailing address)			

WELL LOCATION:
sec 3 T 4 N R 3 E ?
12.2 miles North of Blue Mtn
(distance) (direction) (nearest town)

WELL PURPOSE:
(home, irrigation, municipal, industrial)

- WELL COMPLETION DATA:
- (1) diameter (inches) 4"
 - (2) total depth (feet) 240
 - (3) static water level (feet) 65 below top of ground
 - (4) casing Blue 110 (material) (depth)
 - (size) If telescope see back.
 - (5) screen (length) (depth to top)
 - (size) (material)
 - (6) pump 1/2 hp 9 (HP) (yield gpm)
 - (type power)
 - (7) electric log (yes or no)
 - (organization running log)
 - (8) how well bottom plugged Open

RECEIVED


AUG 3 1978

MISS. BD. OF WATER COMMISSIONERS

DRILLERS REMARKS:

If well telescopes please sketch and show depths.

GROUND LEVEL

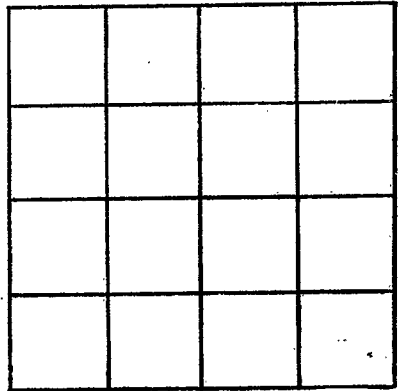

SECTION _____

Please indicate well location X.

ADDITIONAL INFORMATION

If more than one screen, show locations of each on sketch.