

TIPPAH

2000 J ?

6-14-78

MISSISSIPPI BOARD OF WATER COMMISSIONERS
416 North State Street
Jackson, Mississippi 39201

WATER WELL DRILLERS LOG

TIPPAH

June 14 1978
date well completed

Billie R. Scarpson
firm name

county well located


LANDOWNER:	description of formations encountered	from	to
MAURICE SYMS Ripley Miss (mailing address)			
	WHITE CLAY & SAND	50	30
	BLUE CLAY	30	166
	SAND & CLAY	166	174
	LIME STONE & SAND	174	214
	BLUE CLAY	214	255
	LIME STONE & SAND	255	325
WELL LOCATION: sec. <u>4</u> T. <u>8</u> S. R. <u>3</u> E. S. <u>5</u> <u>5</u> miles <u>W</u> of <u>Ripley</u> (distance) (direction) (nearest town)			
WELL PURPOSE: <u>HOME</u> (home, irrigation, municipal, industrial)			
WELL COMPLETION DATA: (1) diameter (inches) <u>4</u> (2) total depth (feet) <u>325</u> (3) static water level (feet) <u>65</u> below above top of ground. (4) casing <u>POC</u> <u>154</u> (material) (depth) (size) if telescope see back. (5) screen <u>NONE</u> (length) (depth to top) (size) (material) (6) pump <u>1/2</u> <u>10</u> (HP) (yield gpm) <u>Elec</u> (type power) (7) electric log <u>NO</u> (yes or no) (organization running log) (8) how well bottom plugged <u>NONE</u>			
DRILLERS REMARKS:			

RECEIVED
JUN 19 1978

MISS. BD. OF WATER COMM

If well telescopes please sketch and show depths.

GROUND LEVEL

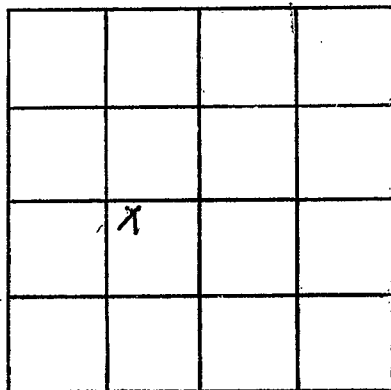

NO NUMBER ON MAP

SECTION _____

Please indicate well location X.

ADDITIONAL INFORMATION

If more than one screen, show locations of each on sketch.