

Tippah  
 J 2007  
 5-28-80

MISSISSIPPI  
 BOARD OF WATER COMMISSIONERS  
 416 North State Street  
 Jackson, Mississippi 39201

WATER WELL DRILLERS LOG

MAY 28 1980 Billy R. Simpson TIPPDAH  
 date well completed firm name county well located

LANDOWNER:  
 MIKE Miller  
 Ripley Miss  
 (mailing address)

description of formations encountered	from	to
SURFACE CLAY	0	4
WHITE CLAY	4	16
ROCK	16	17
YELLOW CLAY	17	20
SAND	20	25

WELL LOCATION:  
 sec. 5 T 4 N R 3 E  
 6 miles W of RIPLEY  
 (distance) (direction) (nearest town)

WELL PURPOSE: HOME  
 (home, irrigation, municipal, industrial)


- WELL COMPLETION DATA:
- diameter (inches) 4
  - total depth (feet) 94
  - static water level (feet) 62 below top of ground.
  - casing PVC 74 (material) (depth)  
 (size) if telescope see back.
  - screen 20 74 (length) (depth to top)  
 4" PVC (size) (material)
  - pump 1/2 10 (HP) (yield gpm)  
 ECCC (type power)
  - electric log NO (yes or no)  
 (organization running log)
  - how well bottom plugged PVC CAP

DEPT. OF NATURAL RESOURCES  
 BUREAU OF LAND & WATER RESOURCES  
 OCT 17 1980  
 RECEIVED

DRILLERS REMARKS:

If well telescopes please sketch and show depths.

GROUND LEVEL

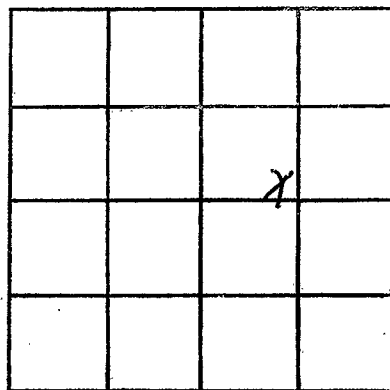

SECTION 5

Please indicate well location X.

ADDITIONAL INFORMATION

If more than one screen,  
show locations of each on sketch.