

Tippah
 J 2009
 10-10-80

MISSISSIPPI
 BOARD OF WATER COMMISSIONERS
 416 North State Street
 Jackson, Mississippi 39201

WATER WELL DRILLERS LOG

OCT 10 1980 Billy R Simpson Tippah
 date well completed firm name county well located

LANDOWNER:
 O. S. Linville
 Ripley Miss
 (mailing address)

description of formations encountered	from	to
SURFACE CLAY	0	3
SOAPSTONE (CASING)	3	26
BLUE CLAY	26	157
LIMESTONE & SAND	157	205
BLUE CLAY	205	252
LIMESTONE & SAND	252	314

WELL LOCATION:
 sec 9 T 4 R 3 S W of Ripley
 (distance) (direction) (nearest town)

WELL PURPOSE: Home
 (home, irrigation, municipal, industrial)

WELL COMPLETION DATA:
 (1) diameter (inches) 4
 (2) total depth (feet) 314
 (3) static water level (feet) 124 below top of ground.
 (4) casing PVC 155 (material) (depth)
 (size) If telescope see back.
 (5) screen None (length) (depth to top)
 (size) (material)
 (6) pump 3/4 10 (HP) (yield gpm)
 Elec (type power)
 (7) electric log No (yes or no)
 (organization running log)
 (8) how well bottom plugged None

DEPT. OF NATURAL RESOURCES
 BUREAU OF LAND & WATER RESOURCES


OCT 17 1980

RECEIVED

DRILLERS REMARKS: SOAPSTONE CLAY HAD TO BE CASSED OFF WITH 2 1/2" 8" CASING

If well telescopes please sketch and show depths.

GROUND LEVEL

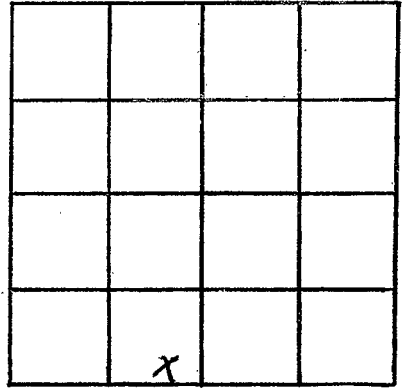

SECTION 9

Please indicate well location X.

ADDITIONAL INFORMATION

If more than one screen,
show locations of each on sketch.