

MISSISSIPPI DEPARTMENT OF NATURAL RESOURCES

Bureau of Land and Water Resources

Southport Mall

P.O. Box 10631

Jackson, Mississippi 39209

WATER WELL DRILLERS LOG

Tippah
J 2012
10-12-81

Oct 12 1981 date well completed Billy R. Simpson firm name Tippah county well located

LANDOWNER:
PETE ELLIOTT
RIPLEY MISS
 (mailing address)

description of formations encountered	from	to
SURFACE CLAY	0	8
SOFTSTONE CLAY	8	16
Blue CLAY	16	70
LIME STONE + SAND	70	131
Blue CLAY	131	165
LIME STONE + SAND	165	250

WELL LOCATION:
 sec. 19 T. 4 N. R. 3 E
5 miles W of RIPLEY
 (distance) (direction) (nearest town)

WELL PURPOSE: HOME
 (home, irrigation, municipal, industrial)

WELL COMPLETION DATA:

(1) diameter (inches) 4

(2) total depth (feet) 250

(3) static water level (feet) 15 ^{below} top of ground

(4) casing POC 65'
 (material) (depth)

 if telescope see back.
 (size)

(5) screen None
 (length) (depth to top)

 (size) (material)
 (6) pump 1/2 10
 (HP) (yield gpm)

Elec
 (type power)

(7) electric log No
 (yes or no)

 (organization running log)

(8) how well bottom plugged None

DRILLERS REMARKS:


DEPT. OF NATURAL RESOURCES
 BUREAU OF LAND & WATER RESOURCES

OCT 15 1981

RECEIVED

If well telescopes please sketch and show depths.

GROUND LEVEL

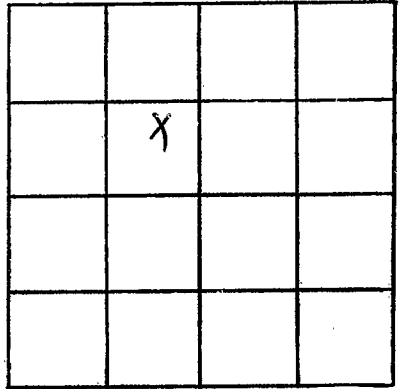

SECTION 19

Please indicate well location X.

ADDITIONAL INFORMATION

If more than one screen, show locations of each on sketch.