

MISSISSIPPI DEPARTMENT OF NATURAL RESOURCES
Bureau of Land and Water Resources
 Southport Mall
 P.O. Box 10631
 Jackson, Mississippi 39209
WATER WELL DRILLERS LOG

[Handwritten signature]

Tippah
8 2014

8-23 1983 Wilson Well Co. Inc. Tippah
 date well completed firm name county well located

LANDOWNER: Alan Brady
RT 1
Ripley Ms
 (mailing address)
 WELL LOCATION:
 sec. 9 T. 4 N. R. 3 E
5 miles NW of Ripley
 (distance) (direction) (nearest town)

description of formations encountered	from	to
<u>Sand & Brown clay</u>	<u>0</u>	<u>18</u>
<u>Black clay</u>	<u>18</u>	<u>120</u>
<u>Rock</u>	<u>120</u>	<u>195</u>
<u>Blue clay & rock</u>	<u>120</u>	<u>216</u>
<u>Rock</u>	<u>195</u>	<u>216</u>
<u>Brown Sand & slacks</u>	<u>216</u>	<u>250</u>

WELL PURPOSE: Home
 (home, irrigation, municipal, industrial)

WELL COMPLETION DATA:
 (1) diameter (inches) 4"
 (2) total depth (feet) 250
 (3) static water level (feet) 110 below above top of ground.
 (4) casing Plastic 250
 (material) (depth)
4 if telescope see back.
 (size)
 (5) screen 10 Plastic
 (length) (depth to top) (material)
4" Plastic
 (size) (material)
 (6) pump 1 12
 (HP) (yield gpm)
Electric
 (type power)
 (7) electric log NO
 (yes or no)
 (organization running log)
 (8) how well bottom plugged 4"
Plastic cap

DRILLERS REMARKS:


DEPT. OF NATURAL RESOURCES
 BUREAU OF LAND & WATER RESOURCES

SEP 19 1983

RECEIVED

If well telescopes please
sketch and show depths.

GROUND LEVEL

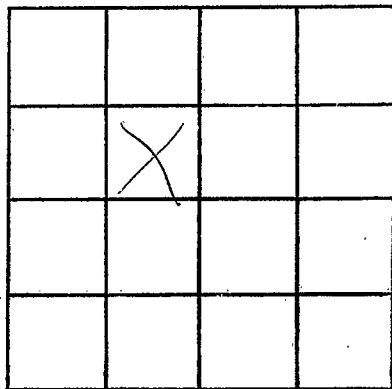

SECTION 9

Please indicate well location X.

ADDITIONAL INFORMATION

If more than one screen,
show locations of each on sketch.