

MISSISSIPPI DEPARTMENT OF NATURAL RESOURCES

Bureau of Land and Water Resources

Southport Mall

P.O. Box 10631

Jackson, Mississippi 39209

WATER WELL DRILLERS LOG

*J. J. Park*  
*J 2015*

Sept 13 1983 date well completed      Billy R. Simpson firm name      Tippah county well located

LANDOWNER:  
FRED BARNES  
RIPLEY MISS  
 (mailing address)

description of formations encountered	from	to
	SURFACE CLAY	0
SAND	8	75
ROCK	73	74
Blue CLAY	74	224
LIMESTONE + SAND	224	276
Blue CLAY	276	312
LIMESTONE + SAND	312	365

WELL LOCATION:  
 sec. 5 T. 4 N. R. 3 E.  
5 miles W of RIPLEY  
 (distance) (direction) (nearest town)

WELL PURPOSE: Home  
 (home, irrigation, municipal, industrial)

- WELL COMPLETION DATA:
- (1) diameter (inches) 4
  - (2) total depth (feet) 365
  - (3) static water level (feet) 117 below ~~above~~ top of ground.
  - (4) casing POC 160  
 (material) (depth)
  - if telescope see back.  
 (size)
  - (5) screen NONE  
 (length) (depth to top)
  - (size) (material)
  - (6) pump 1/2 10  
 (HP) (yield gpm)
  - Elec  
 (type power)
  - (7) electric log NO  
 (yes or no)
  - (organization running log)
  - (8) how well bottom plugged NONE


DRILLERS REMARKS:

DEPT. OF NATURAL RESOURCES  
 BUREAU OF LAND & WATER RESOURCES

SEP 29 1983  
 RECEIVED

If well telescopes please sketch and show depths.

GROUND LEVEL

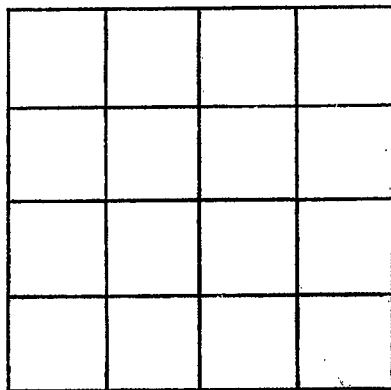

SECTION \_\_\_\_\_

Please indicate well location X.

ADDITIONAL INFORMATION

If more than one screen, show locations of each on sketch.