

Zippah  
 R 8  
 10-5-68

MISSISSIPPI  
 BOARD OF WATER COMMISSIONERS  
 416 North State Street  
 Jackson, Mississippi 39201

CODED

WATER WELL DRILLERS LOG

10-5-1968 date well completed  
 Jungers Well Co. firm name  
 Zippah county well located

LANDOWNER: Brown  
Derald Brown  
Ripley  
 (mailing address)

description of formations encountered	from	to
<u>mixed clay</u>	<u>0</u>	<u>100</u>
<u>clay + rock</u>	<u>100</u>	<u>160</u>

WELL LOCATION:  
 sec. 6 T 4 S R 4 E  
2 miles NO. of Ripley  
 (distance) (direction) (nearest town)

WELL PURPOSE: Home  
 (home, irrigation, municipal, industrial)

- WELL COMPLETION DATA:
- (1) diameter (inches) 4"
- (2) total depth (feet) 160 ft.
- (3) static water level (feet) 50 below top of ground.
- (4) casing PVC, 80  
 (material) (depth)  
4" if telescope see back.  
 (size)
- (5) screen 0, 0  
 (length) (depth to top)  
0, 0  
 (size) (material)
- (6) pump 3/4, 8  
 (HP) (yield gpm)  
Elec  
 (type power)
- (7) electric log No  
 (yes or no)  
0  
 (organization running log)
- (8) how well bottom plugged 0


CODED

DRILLERS REMARKS:

0 1 0 1968  
 MISS. BD. OF  
 WATER COMMISSIONERS

If well telescopes please sketch and show depths.

GROUND LEVEL

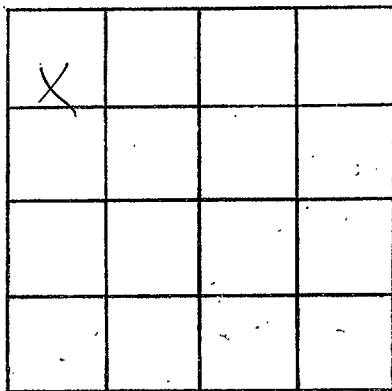

SECTION 6

Please indicate well location X.

ADDITIONAL INFORMATION

If more than one screen,  
show locations of each on sketch.