

TIPPAN
K 10
2-14-70

MISSISSIPPI
BOARD OF WATER COMMISSIONERS
416 North State Street
Jackson, Mississippi 39201

CODED

WATER WELL DRILLERS LOG

9 14 70 date well completed
J T Medlin firm name
Tippah county well located

LANDOWNER: P. J. Child
Ripley
(mailing address)

description of formations encountered	from	to
	Red Clay	0
Sand	18	62
Blue "	62	72
Sand	72	140

WELL LOCATION:
sec. 11 T. 4 N. R. 4 E
4 miles N.E. of Ripley
(distance) (direction) (nearest town)

WELL PURPOSE:
(home, irrigation, municipal, industrial)

- WELL COMPLETION DATA:
- (1) diameter (inches) 4
 - (2) total depth (feet) 140
 - (3) static water level (feet) 109 below top of ground.
 - (4) casing P, 140, (material) (depth)
(size) if telescope see back.
 - (5) screen 40, 100 (length) (depth to top)
(size) (material)
 - (6) pump 1/2, 4 (HP) (yield gpm)
E (type power)
 - (7) electric log (yes or no)
 - (organization running log)
 - (8) how well bottom plugged Chuff

CODED


OCT 7 1970

DRILLERS REMARKS:

MISS. Bd. of
WATER COMMISSIONERS

If well telescopes please sketch and show depths.

GROUND LEVEL

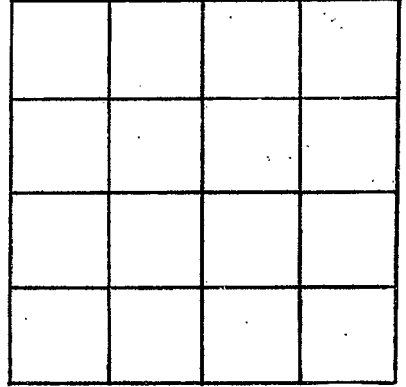

SECTION _____

Please indicate well location X.

ADDITIONAL INFORMATION

If more than one screen,
show locations of each on sketch.