

MISSISSIPPI
BOARD OF WATER COMMISSIONERS
416 North State Street
Jackson, Mississippi 39201

CODED

WATER WELL DRILLERS LOG

TIPPAH
K 11
10-19-70

date well completed Oct 19 1970 firm name J. T. Madhri county well located Tippha

LANDOWNER: H. D. Mauney
Hwy 2 E. Mauney
Ripley
(mailing address)

description of formations encountered	from	to
	<u>Clay</u>	<u>0</u>
<u>Sand</u>	<u>13</u>	<u>109</u>
<u>Rock</u>	<u>109</u>	<u>116</u>
<u>Rock</u>	<u>109</u>	<u>116</u>
<u>Sand</u>	<u>116</u>	<u>136</u>
<u>Blue</u>	<u>136</u>	<u>140</u>

WELL LOCATION:
sec. 14 T 4 N R 40 E
5 miles E of Ripley
(distance) (direction) (nearest town)

WELL PURPOSE:
(home, irrigation, municipal, industrial)

WELL COMPLETION DATA:

(1) diameter (inches) 4

(2) total depth (feet) 140

(3) static water level (feet) 20 below above top of ground.

(4) casing P 140
(material) (depth)
(size) if telescope see back.

(5) screen 20 120
(length) (depth to top)
4 P
(size) (material)

(6) pump 1 6
(HP) (yield gpm)
2
(type power)

(7) electric log _____
(yes or no)
(organization running log)

(8) how well bottom plugged Blue

CODED


NOV 4 1970

DRILLERS REMARKS:

MISS. BD. OF
WATER COMM.

If well telescopes please sketch and show depths.

GROUND LEVEL

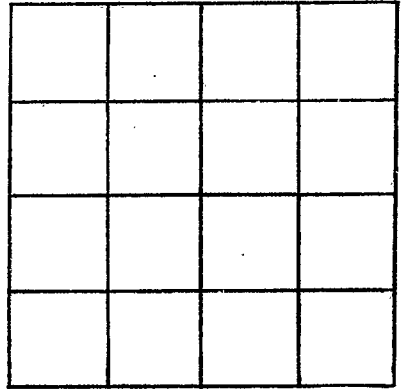

SECTION _____

Please indicate well location X.

ADDITIONAL INFORMATION

If more than one screen, show locations of each on sketch.