

650.00
3250
25⁰⁰

TIPPAH
K12
10-13-71

MISSISSIPPI
BOARD OF WATER COMMISSIONERS
416 North State Street
Jackson, Mississippi 39201

CODED

WATER WELL DRILLERS LOG

10 23 19 71 date well completed
J T Medlin firm name
Tippah county well located

LANDOWNER: E. R. Hutchins
Ripley
(mailing address)

description of formations encountered
Clay
Sand
from 0 to 18
18 110

WELL LOCATION:
sec. 9 T 4 N R 4 E
S W
3 miles E of Ripley
(distance) (direction) (nearest town)

WELL PURPOSE:
(home, irrigation, municipal, industrial)

- WELL COMPLETION DATA:
- (1) diameter (inches) 4
 - (2) total depth (feet) 110
 - (3) static water level (feet) 40 below top of ground.
 - (4) casing P 110 (material) (depth)
 - (size) if telescope see back.
 - (5) screen 10 100 (length) (depth to top)
 - 4 P (size) (material)
 - (6) pump 1 6 (HP) (yield gpm)
 - E (type power)
 - (7) electric log (yes or no)
 - (organization running log)
 - (8) how well bottom plugged

CODED


NOV 16 1971

MISS. BD. OF
WATER COMM.

DRILLERS REMARKS:

If well telescopes please
sketch and show depths.

GROUND LEVEL

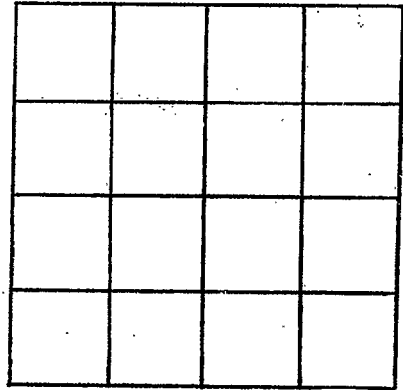

SECTION _____

Please indicate well location X.

ADDITIONAL INFORMATION

Horizontal lines for additional information.

If more than one screen,
show locations of each on sketch.