

*Jippek*  
**K13**  
 12-67

MISSISSIPPI  
 BOARD OF WATER COMMISSIONERS  
 416 North State Street  
 Jackson, Mississippi 39201

WATER WELL DRILLERS LOG


*December 11* 19 *67* *Jumper Well Co.* *Jippek*  
 date well completed firm name county well located

| LANDOWNER:  | description of formations encountered | from     | to         |
|---|---------------------------------------|----------|------------|
| <i>Buddy Corneilus</i><br><i>Ripley, Miss</i><br>(mailing address)  |                                       |          |            |
| WELL LOCATION:<br>sec. <i>5</i> T. <i>9</i> N R. <i>4</i> E<br><i>4</i> miles <i>east</i> of <i>Ripley</i><br>(distance) (direction) (nearest town) | <i>water bearing sand</i>             | <i>0</i> | <i>180</i> |
| WELL PURPOSE: <i>home</i><br>(home, irrigation, municipal, industrial)  |                                       |          |            |
| WELL COMPLETION DATA:   |                                       |          |            |
| (1) diameter (inches) <i>4</i>  |                                       |          |            |
| (2) total depth (feet) <i>180</i>   |                                       |          |            |
| (3) static water level (feet) <i>85</i> <i>below</i> above top of ground.   |                                       |          |            |
| (4) casing <i>PVC</i> , <i>185</i> ,<br>(material) (depth)<br><br>_____ If telescope see back.<br>(size)  |                                       |          |            |
| (5) screen <i>20</i> , <i>150</i><br>(length) (depth to top)<br><i>1/32 gravel packed</i><br>(size) (material)                                      |                                       |          |            |
| (6) pump <i>1</i> , <i>12 gal.</i><br>(HP) (yield gpm)<br><i>electric</i><br>(type power)   |                                       |          |            |
| (7) electric log <i>no</i><br>(yes or no)<br><i>yes</i><br>(organization running log)   |                                       |          |            |
| (8) how well bottom plugged <i>Pvc plug</i>   |                                       |          |            |
| DRILLERS REMARKS:   |                                       |          |            |

JUN 26 1967  
 MISS. BOARD OF  
 WATER COMMISSIONERS

If well telescopes please sketch and show depths.

GROUND LEVEL

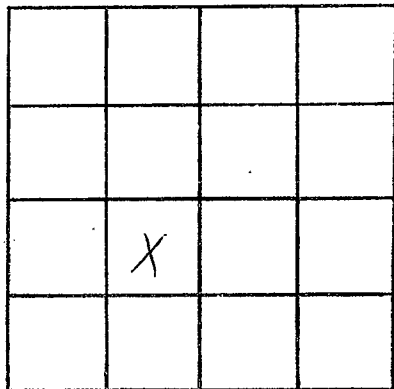

SECTION \_\_\_\_\_

Please indicate well location X.

ADDITIONAL INFORMATION

If more than one screen,  
show locations of each on sketch.