

TIPPAH
K 14
12-12-71

MISSISSIPPI
BOARD OF WATER COMMISSIONERS
416 North State Street
Jackson, Mississippi 39201

for 650.00
32.50
682.50

WATER WELL DRILLERS LOG

12-12-1971 J.T. Medlin Tippah
date well completed firm name county well located


LANDOWNER: Robert Cimino	description of formations encountered	from	to
Ripley Miss (mailing address)	Clay Sand Rock & Clay Sand & Rock	0 12 47 100	18 47 116 180
WELL LOCATION: sec. 17 T 4 N R 4 E 3 miles E of Ripley (distance) (direction) (nearest town)			
WELL PURPOSE: (home, irrigation, municipal, industrial)			
WELL COMPLETION DATA:			
(1) diameter (inches) 4			
(2) total depth (feet) 180			
(3) static water level (feet) 108 below top of ground.			
(4) casing P 80 (material) (depth)			
(size) If telescope see back.			
(5) screen (length) (depth to top)			
(size) (material)			
(6) pump 1/2 (HP) 7 (yield gpm)			
(type power)			
(7) electric log (yes or no)			
(organization running log)			
(8) how well bottom plugged			
DRILLERS REMARKS:			

JAN 5 1972

MISS. BD. OF
WATER COMMISSIONERS

If well telescopes please sketch and show depths.

GROUND LEVEL

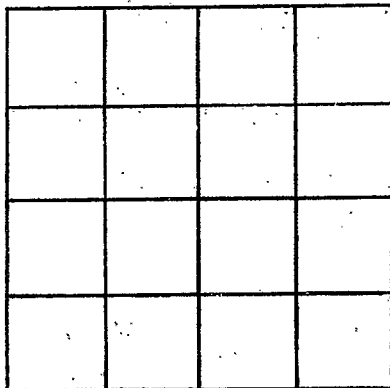

SECTION _____

Please indicate well location X.

ADDITIONAL INFORMATION

If more than one screen,
show locations of each on sketch.