

850-07 Forwell
-42.50 FAS

TIPPAH
K 15
7-6-72

MISSISSIPPI
BOARD OF WATER COMMISSIONERS
416 North State Street
Jackson, Mississippi 39201

4292.50

WATER WELL DRILLERS LOG

7-6-72 19 J. T. Medlin Tippah
date well completed firm name county well located


LANDOWNER: <u>Dowitt Haynes</u>	description of formations encountered	from	to
<u>Dumas</u> (mailing address)	<u>Clay</u> <u>Sand Clay</u> <u>Sand & Shellrock</u>	<u>0</u> <u>20</u> <u>130</u>	<u>20</u> <u>130</u> <u>180</u>
WELL LOCATION: sec. <u>4</u> T <u>4</u> N R <u>40</u> <u>3</u> miles <u>East</u> of <u>Dumas</u> (distance) (direction) (nearest town)			
WELL PURPOSE: (home, irrigation, municipal, industrial)			
WELL COMPLETION DATA:			
(1) diameter (inches) <u>4"</u>			
(2) total depth (feet) <u>180'</u>			
(3) static water level (feet) _____ below top of ground.			
(4) casing <u>Plastic 180'</u> (material) (depth)			
_____ if telescope see back. (size)			
(5) screen <u>10'</u> <u>170</u> (length) (depth to top)			
_____ <u>4"</u> <u>Plastic</u> (size) (material)			
(6) pump <u>1 1/2</u> <u>90'</u> (HP) (yield gpm)			
_____ <u>Electric</u> (type power)			
(7) electric log _____ (yes or no)			
_____ (organization running log)			
(8) how well bottom plugged _____			
DRILLERS REMARKS:			

AUG 9 2 1972

MISS. BD. OF
WATER COMMISSIONERS

If well telescopes please sketch and show depths.

GROUND LEVEL

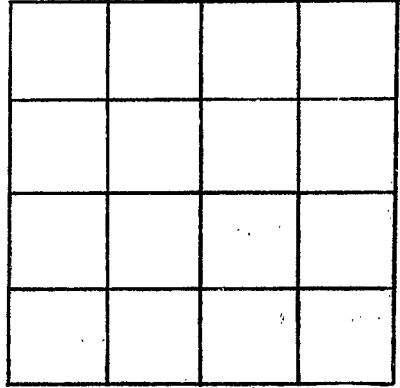

SECTION _____

Please indicate well location X.

ADDITIONAL INFORMATION

If more than one screen,
show locations of each on sketch.