

TIPPANH
K 16
3-16-71

MISSISSIPPI
BOARD OF WATER COMMISSIONERS
416 North State Street
Jackson, Mississippi 39201

WATER WELL DRILLERS LOG


3-16-71 19 Juniper Deep Drilling Tippah
date well completed firm name county well located

LANDOWNER:	description of formations encountered	from	to
<u>Lorenzo Gibbs</u> <u>#1 Helmer</u> (mailing address)	<u>mixed clay</u>	<u>0</u>	<u>60</u>
WELL LOCATION: sec. <u>5</u> T <u>4</u> N R <u>4</u> E <u>5</u> miles <u>W</u> of <u>Helmer</u> (distance) (direction) (nearest town)	<u>Clay</u>	<u>50</u>	<u>120</u>
WELL PURPOSE: (home, irrigation, municipal, industrial)	<u>Rock & Sand</u>	<u>120</u>	<u>200</u>
WELL COMPLETION DATA: (1) diameter (inches) <u>4"</u> (2) total depth (feet) <u>200</u> (3) static water level (feet) <u>50</u> below above top of ground. (4) casing <u>PVC</u> <u>100</u> (material) (depth) <u>4"</u> if telescope see back. (size) (5) screen <u>0</u> <u>0</u> (length) (depth to top) <u>0</u> (size) (material) (6) pump <u>1/2</u> <u>10</u> (HP) (yield gpm) <u>Electric</u> (type power) (7) electric log <u>0</u> (yes or no) (organization running log) (8) how well bottom plugged <u>0</u>			
DRILLERS REMARKS:			

NOV 20 1972

If well telescopes please sketch and show depths.

GROUND LEVEL

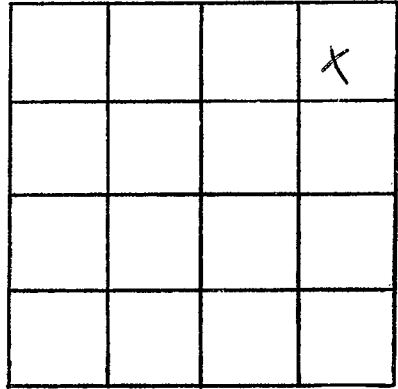

SECTION 5

Please indicate well location X.

ADDITIONAL INFORMATION

If more than one screen, show locations of each on sketch.