

TIPPAH  
K 17  
12-8-71

MISSISSIPPI  
BOARD OF WATER COMMISSIONERS  
416 North State Street  
Jackson, Mississippi 39201

WATER WELL DRILLERS LOG

12-8-71  
date well completed


Joseph W. Kelly  
firm name

Tippah  
county well located

LANDOWNER:	description of formations encountered	from	to
Wayne Anthony Rt # 2 - Belvidere (mailing address)	mixed clay clay Rock & sand	0 50 120	60 120 200
WELL LOCATION: sec. 5 T 4 R 4 E 5 miles (distance) S W of Gleda (nearest town)			
WELL PURPOSE: 1000 gal (home, irrigation, municipal, industrial)			
WELL COMPLETION DATA:			
(1) diameter (inches) 4"			
(2) total depth (feet) 200			
(3) static water level (feet) 50 below top of ground			
(4) casing 4" (material) 100' (depth) (size) if telescope see back.			
(5) screen 0 (length) 0 (depth to top) (size) 1/2 (material)			
(6) pump 1/2 (HP) 10 (yield gpm) (type power) Elec			
(7) electric log (yes or no) no			
(organization running log)			
(8) how well bottom plugged 0			
DRILLERS REMARKS:	NOV 24 1972		

If well telescopes please sketch and show depths.

GROUND LEVEL

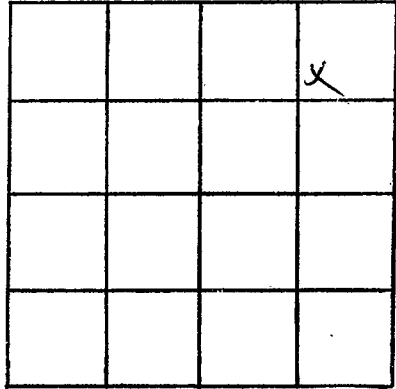

SECTION 5

Please indicate well location X.

ADDITIONAL INFORMATION

If more than one screen, show locations of each on sketch.