

TIPPAH
K 18
3-9-71

MISSISSIPPI
BOARD OF WATER COMMISSIONERS
416 North State Street
Jackson, Mississippi 39201

WATER WELL DRILLERS LOG

3-9-71 19 date well completed
Jungel Well Drilling firm name
Tippha county well located

LANDOWNER:	description of formations encountered	from	to
Michael Kaser Dunn, Miss (mailing address)	mud clay sand & gravel	0 130	130 180
WELL LOCATION: sec 21 T 4 S R 4 E 4 miles (distance) SE of Dunn (nearest town)			
WELL PURPOSE: Home (home, irrigation, municipal, industrial)			
WELL COMPLETION DATA: (1) diameter (inches) 4" (2) total depth (feet) 180 (3) static water level (feet) 100 below top of ground. (4) casing PVC 140 (material), 4" (depth), 4" (size) if telescope see back. (5) screen 40 140 (length), (depth to top), 4 (size), PVC (material) (6) pump 1 1/2 8 (HP), (yield gpm), Eoar- (type power) (7) electric log No (yes or no), 0 (organization running log) (8) how well bottom plugged PVCCP			
DRILLERS REMARKS:	NOV 20 1972		


If well telescopes please sketch and show depths.

GROUND LEVEL

Casing 140 ft

Screen 40 ft

18 ft.

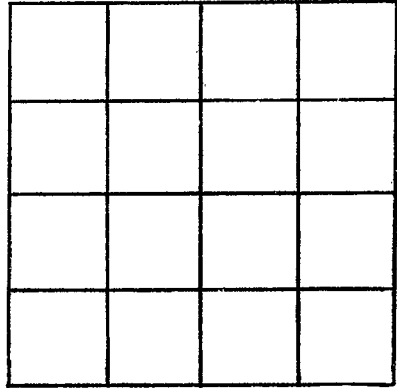

SECTION _____

Please indicate well location X.

ADDITIONAL INFORMATION

Lined area for additional information.

If more than one screen, show locations of each on sketch.