

TIPPAH
K 19
2-26-71

MISSISSIPPI
BOARD OF WATER COMMISSIONERS
416 North State Street
Jackson, Mississippi 39201

WATER WELL DRILLERS LOG


2-26-71 19 date well completed
Jumper Well Drilling firm name
Tippha county well located

LANDOWNER:	description of formations encountered	from	to
Jerry Bates Rt # 1, Ripley Miss. (mailing address)	mixed clay blue clay	0	50 150
WELL LOCATION: sec. 29 T 4 R 4 E 4 miles NE of Ripley (distance) (direction) (nearest town)	rock & sand	150	200
WELL PURPOSE: home (home, irrigation, municipal, industrial)			
WELL COMPLETION DATA: 4"1			
(1) diameter (inches)			
(2) total depth (feet) 200			
(3) static water level (feet) 80 below top of ground.			
(4) casing PVC, 200 (material) (depth)			
NO (size) if telescope see back.			
(5) screen 0 0 (length) (depth to top)			
5 (size) 0 (material)			
(6) pump 1 8 (HP) (yield gpm)			
Eger (type power)			
(7) electric log NO (yes or no)			
(organization running log)			
(8) how well bottom plugged 0			
DRILLERS REMARKS:			

MISSISSIPPI
BOARD OF WATER COMMISSIONERS
JAN 1971

If well telescopes please sketch and show depths.

GROUND LEVEL

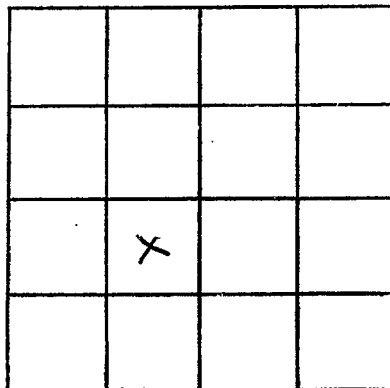

SECTION 29

Please indicate well location X.

ADDITIONAL INFORMATION

If more than one screen,
show locations of each on sketch.