

TIPPAH
K 20
11-18-72

MISSISSIPPI
BOARD OF WATER COMMISSIONERS
416 North State Street
Jackson, Mississippi 39201

620.00
~~CODED~~

WATER WELL DRILLERS LOG

11 18 19 72 *J. Medlin* *Tippan*
date well completed firm name county/well located

LANDOWNER:
Creeley Johnson
Ripley
(mailing address)

description of formations encountered	from	to
<i>red clay</i>	<i>0</i>	<i>18</i>
<i>rock + clay</i>	<i>18</i>	<i>60</i>
<i>sand</i>	<i>60</i>	<i>90</i>

WELL LOCATION:
sec. *22* T *4* N R *4* E
4 miles *E* of *Ripley*
(distance) (direction) (nearest town)

WELL PURPOSE:
(home, irrigation, municipal, industrial)

- WELL COMPLETION DATA:
- (1) diameter (inches) *4*
 - (2) total depth (feet) *90*
 - (3) static water level (feet) *12* below top of ground.
 - (4) casing *P* *90*
(material) (depth)
4 if telescope see back.
(size)
 - (5) screen *10* *80*
(length) (depth to top)
4 *P*
(size) (material)
 - (6) pump *1/2* *6*
(HP) (yield gpm)
E
(type power)
 - (7) electric log _____
(yes or no)

(organization running log)
 - (8) how well bottom plugged *cap*


~~CODED~~

DRILLERS REMARKS:

DEC 9 1972

If well telescopes please sketch and show depths.

GROUND LEVEL

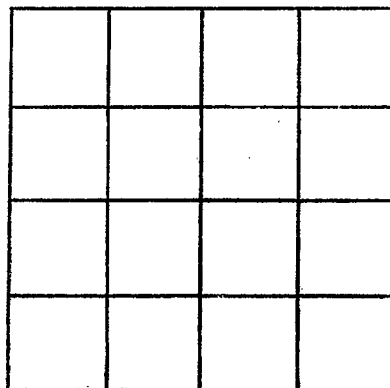

SECTION _____

Please indicate well location X.

ADDITIONAL INFORMATION

Lined area for providing additional information.

If more than one screen, show locations of each on sketch.