

TIPPAH
K 21
11-19-72

MISSISSIPPI
BOARD OF WATER COMMISSIONERS
416 North State Street
Jackson, Mississippi 39201

600 00
120 00
00

WATER WELL DRILLERS LOG

CODED

11 19 1972 date well completed
Medlin firm name
Tippah county well located

LANDOWNER:	description of formations encountered	from	to
James Garrison Ripley (mailing address)			

WELL LOCATION:
sec. 6 T 2 N R 4 E
S W
3 miles NE of Ripley
(distance) (direction) (nearest town)

WELL PURPOSE:
(home, irrigation, municipal, industrial)

- WELL COMPLETION DATA:
- (1) diameter (inches) 4
 - (2) total depth (feet) 160
 - (3) static water level (feet) 90 below/above top of ground.
 - (4) casing P 80
(material) (depth)
(size) if telescope see back.
 - (5) screen _____
(length) (depth to top)
(size) (material)
 - (6) pump 1 5
(HP) (yield gpm)
E
(type power)
 - (7) electric log (yes or no) _____
(organization running log)
 - (8) how well bottom plugged _____


CODED

DRILLERS REMARKS: _____

DEC 21 1972

If well telescopes please sketch and show depths.

GROUND LEVEL

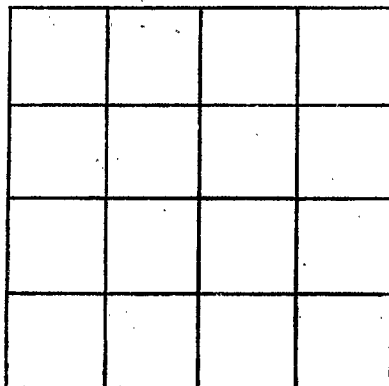

SECTION _____

Please indicate well location X.

ADDITIONAL INFORMATION

A series of horizontal lines for recording additional information, starting below the 'ADDITIONAL INFORMATION' header.

If more than one screen, show locations of each on sketch.