

TIPPAH  
K 22  
12-5-72

MISSISSIPPI  
BOARD OF WATER COMMISSIONERS  
416 North State Street  
Jackson, Mississippi 39201

70000  
CODED  
330

WATER WELL DRILLERS LOG

12-5 1972  
date well completed

J T Medlin  
firm name

Tippah  
county well located

LANDOWNER: Opel Johnson  
Ripley

description of formations encountered

from to

Red clay	0	17
blue clay & rock	17	73
black clay	73	122
rock & sand	122	185

(mailing address)

WELL LOCATION:

sec. 22 T 4 N R 9 E  
3 miles SE of Ripley  
(distance) (direction) (nearest town)

WELL PURPOSE:

(home, irrigation, municipal, industrial)

WELL COMPLETION DATA:

- (1) diameter (inches) 4
- (2) total depth (feet) 185
- (3) static water level (feet) 93 below top of ground.
- (4) casing P 65  
(material) (depth)  
(size) If telescope see back.
- (5) screen 2 1  
(length) (depth to top)  
(size) (material)
- (6) pump 1 5  
(HP) (yield gpm)  
(type power)
- (7) electric log yes or no

(organization running log)

(8) how well bottom plugged open


CODED

FEB 5 1973

DRILLERS REMARKS:

If well telescopes please sketch and show depths.

GROUND LEVEL

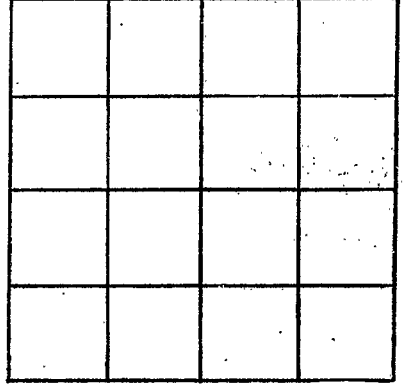

SECTION \_\_\_\_\_

Please indicate well location X.

ADDITIONAL INFORMATION

If more than one screen,  
show locations of each on sketch.