

K 23
TIPPAH
6-28-73

MISSISSIPPI
 BOARD OF WATER COMMISSIONERS
 416 North State Street
 Jackson, Mississippi 39201

850 00
 42 00
 82.00

CODED

WATER WELL DRILLERS LOG

6 28 19 73 J. T. Modlin Tippah
 date well completed firm name county/well located


LANDOWNER:	description of formations encountered	from	to
<u>Roscoe Dindings</u>			
<u>Rogers</u> (mailing address)	<u>rock + sand</u>	<u>18</u>	<u>145</u>
WELL LOCATION:			
sec. <u>36</u> T. <u>4</u> S. R. <u>4</u> E. <u>W</u>			
<u>3</u> miles <u>3</u> of <u>Mitchell</u>			
(distance) (direction) (nearest town)			
WELL PURPOSE: (home, irrigation, municipal, industrial)			
WELL COMPLETION DATA:			
(1) diameter (inches) <u>4</u>			
(2) total depth (feet) <u>145</u>			
(3) static water level (feet) <u>70</u> below/above top of ground.			
(4) casing <u>P</u> <u>145</u> (material) (depth)			
(size) if telescope see back.			
(5) screen <u>10</u> <u>135</u> (length) (depth to top)			
(size) (material)			
(6) pump <u>1</u> <u>5</u> (HP) (yield gpm)			
<u>E</u> (type power)			
(7) electric log _____ (yes or no)			
(organization running log)			
(8) how well bottom plugged <u>Cap</u>			
DRILLERS REMARKS:			

CODED

AUG 22 1973

If well telescopes please sketch and show depths.

GROUND LEVEL

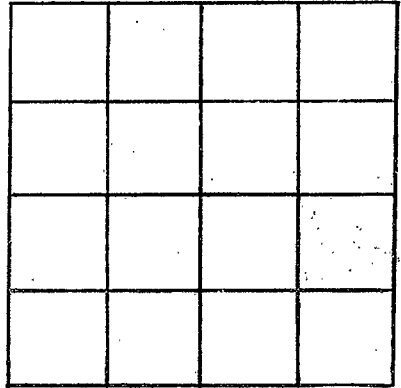

SECTION _____

Please indicate well location X.

ADDITIONAL INFORMATION

If more than one screen,
show locations of each on sketch.