

TIPPAN
K25
8-24-74

MISSISSIPPI
BOARD OF WATER COMMISSIONERS
416 North State Street
Jackson, Mississippi 39201

400.⁰⁰
T 45 00
945 00

CODED

WATER WELL DRILLERS LOG

8-24 19 24 JT Medlin Tippah
date well completed. firm name county well located

LANDOWNER: W. H. Johnson
Repley
(mailing address)

description of formations encountered	from	to
Red clay	0	78
Blue "s"	78	98
rock sand	98	210

WELL LOCATION:
sec. 12 T. 4 N. R. 4 E
S W
(distance) miles (direction) of (nearest town)

WELL PURPOSE:
(home, irrigation, municipal, industrial)

- WELL COMPLETION DATA:
- (1) diameter (inches) 4
 - (2) total depth (feet) 210
 - (3) static water level (feet) 90 below top of ground.
 - (4) casing (material) P, (depth) 150.
If telescope see back. (size)
 - (5) screen (length) 0, (depth to top) 0.
(size) (material)
 - (6) pump (HP) 5, (yield gpm) 8.
(type power) E
 - (7) electric log (yes or no) _____
(organization running log) _____
 - (8) how well bottom plugged _____


DRILLERS REMARKS:

RECEIVED
SEP - 5 1974

MISS. BD. OF WATER COMMISSIONERS

If well telescopes please
sketch and show depths.

GROUND LEVEL

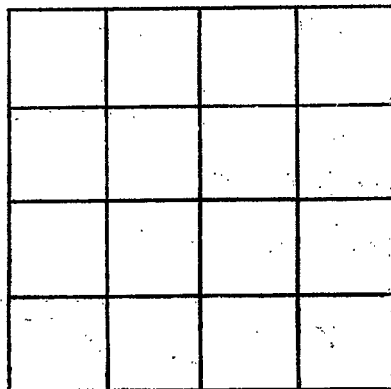

SECTION _____

Please indicate well location X.

ADDITIONAL INFORMATION

If more than one screen,
show locations of each on sketch.