

TIPPAAW
K26
4-4-75

MISSISSIPPI
BOARD OF WATER COMMISSIONERS
416 North State Street
Jackson, Mississippi 39201

CODED

WATER/WELL DRILLERS LOG

4 4 19 75 JT Wodkin Tippah
date well completed firm name county/well located

LANDOWNER: Johnny Long description of formations encountered from to
Blue water red clay 0 12
City " sand 12 33
(mailing address) rock + clay 23 65
Blue clay 65 145
Rock gravel 145 198

WELL LOCATION:
sec. 17 T 4 N R 4 E
2 miles S E of Ripley
(distance) (direction) (nearest town)

WELL PURPOSE:
(home, irrigation, municipal, industrial)

WELL COMPLETION DATA:
(1) diameter (inches) 4
(2) total depth (feet) 178
(3) static water level (feet) 85 below above top of ground.
(4) casing P 85 (material) (depth)
_____ If telescope see back. (size) _____
(5) screen _____ (length) _____ (depth to top) (size) _____ (material) _____
(6) pump 5 7 (HP) (yield gpm)
C (type power)
(7) electric log _____ (yes or no)
_____ (organization running log)
(8) how well bottom plugged _____

CODED


RECEIVED
APR 18 1975

MISS. BD. OF WATER COMMISSIONERS

DRILLERS REMARKS:

If well telescopes please sketch and show depths.

GROUND LEVEL

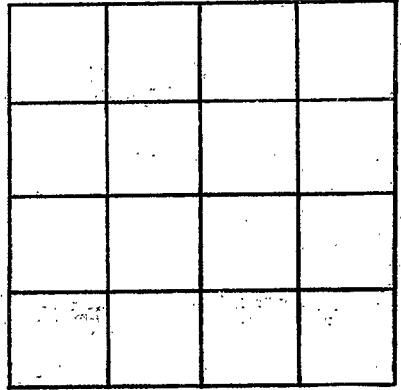

SECTION _____

Please indicate well location X.

ADDITIONAL INFORMATION

If more than one screen,
show locations of each on sketch.