

MISSISSIPPI
BOARD OF WATER COMMISSIONERS
416 North State Street
Jackson, Mississippi 39201

CODED

WATER WELL DRILLERS LOG

Jippah
K 27
4-10-75

11-10 1975
date well completed

Bonds Well Drilling
firm name

Jippah
Penton
county well located

| LANDOWNER: Concord Church (Parsonage), Bonneville, Missisipp. | description of formations encountered | from | to |
|--|--|---------------|----------------|
| (mailing address) | Red clay Red Sand Water Sand | 0 32 50 | 32 50 88 |
| WELL LOCATION: sec. 35 T 4 N R 4 E 10 miles W of Boo. (distance) (direction) (nearest town) | | | |
| WELL PURPOSE: Home (home, irrigation, municipal, industrial) | | | |
| WELL COMPLETION DATA: | | | |
| (1) diameter (inches) 14 1/2" | | | |
| (2) total depth (feet) 88' | | | |
| (3) static water level (feet) 40 below top of ground. | | | |
| (4) casing Plastic, 88' (material) (depth) | | | |
| (size) If telescope see back. | | | |
| (5) screen Perforated (length) (depth to top) | | | |
| (size) (material) | | | |
| (6) pump 3/4 10 (HP) (yield gpm) | | | |
| E0000 (type power) | | | |
| (7) electric log NO (yes or no) | | | |
| (organization running log) | | | |
| (8) how well bottom plugged Plugged | | | |
| DRILLERS REMARKS: | | | |
| | | | |
| | | | |


CODED

RECEIVED
MAY 1975

MAY 24 1975

If well telescopes please sketch and show depths.

GROUND LEVEL

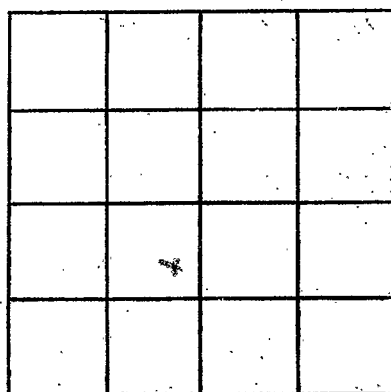

SECTION _____

Please indicate well location X.

ADDITIONAL INFORMATION

Lined area for providing additional information.

If more than one screen, show locations of each on sketch.