

# MISSISSIPPI DEPARTMENT OF NATURAL RESOURCES

Bureau of Land and Water Resources

COUNTY WELL LOCATED <b>TIPPAH</b>		
WELL NUMBER <b>K 29</b>	CODED <b>COVERED</b>	PERMIT NUMBER
<b>2893</b>		NAME OF DRILLING FIRM <b>J. W. WEBB &amp; SONS</b>
DATE WELL COMPLETED <b>APR 1987</b>		<b>INC.</b>

P.O. Box 10631  
Jackson, Mississippi 39209  
WATER WELL DRILLERS LOG


NAME & MAILING ADDRESS OF LANDOWNER <b>MITCHELL WATER ASSOC.</b>		
<b>RIPLEY MS</b>		
WELL LOCATION: SEC	TOWNSHIP	RANGE
<b>25</b>	<b>4 S</b>	<b>4 E</b>
DISTANCE	DIRECTION	NEAREST TOWN
<b>7</b> Miles	<b>E</b> of	<b>RIPLEY</b>
OTHER LANDMARK		
WELL PURPOSE: Home, Irrigation, <u>Municipal</u> , Industrial, Fish Pond, etc.		

PUMP DATA		
PUMP TYPE (Circle One): Submersible, <u>Turbine</u> , Jet, Flowing Well, Other (Describe) _____		
POWER TYPE (Circle One): <u>Electric</u> , Tractor, Diesel, Gasoline, Butane, Other (Describe) _____		
Pump Capacity (GPM) <b>250</b>	No. of Stages <b>13</b>	Setting Depth <b>470</b> FT.
PUMP TEST		
Well yielded <b>250</b> GPM with a drawdown of <b>94</b> ft. after <b>24</b> hours of pumping		

WELL DATA		
Well Depth <b>834</b>	Casing Diameter (In.) <b>10</b>	Casing Length (Ft.) <b>760</b>
Type of Casing <b>STEEL</b>	Hole Depth <b>325</b>	Depth to Static Water Level <b>325</b>
TYPE OF COMPLETION: (Circle One or More): <u>Gravel Packed</u> , <u>Underreamed</u> , Telescoped, Natural Development, Open Hole, Other (Describe) _____		
Top of Lap Pipe or Reduction in Casing <b>694 FEET</b> IF TELESCOPED OR MORE THAN ONE SCREEN: USE BACK PAGE		

LOG DATA	
TYPE OF LOG RUN (Circle One): <u>Electric</u> , Gamma Ray, Density, Sonic, Neutron, Other (Describe) _____	
Name of Organization Running Log <b>STATE</b>	

SCREEN DATA		
Diameter - Inches <b>6</b>	Length - Feet <b>60</b>	Slot Size - Inches <b>.025</b>
Screen Type <b>55</b>	Depth to Bottom - Feet <b>834</b>	

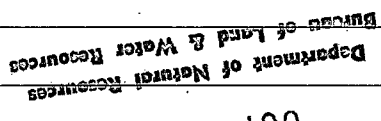
GEOLOGIC DATA (Office Use Only)			
Surface Elev.	Geologic Unit	Unit Thickness	Depth to Top
Subs. SWL	Date	Analysis	Aquifer Test
Driller's Remarks			
			

DESCRIPTION OF FORMATIONS ENCOUNTERED	FROM	TO	FORMATIONS (Continued)	FROM	TO
<b>RED SANDY CLAY</b>	<b>0</b>	<b>60</b>	<div style="font-size: 2em; transform: rotate(-45deg); opacity: 0.5;">RECEIVED</div> <div style="text-align: center;">OCT 15 1987</div>		
<b>SAND &amp; ROCK</b>	<b>60</b>	<b>180</b>			
<b>SANDY CLAY</b>	<b>180</b>	<b>270</b>			
<b>BLUE CLAY</b>	<b>270</b>	<b>720</b>			
<b>SANDY CLAY</b>	<b>720</b>	<b>760</b>			
<b>SAND</b>	<b>760</b>	<b>830</b>			
<b>CLAY</b>	<b>830</b>	<b>860</b>			

IF MORE SPACE IS NEEDED, USE BACK

If well telescopes please  
sketch and show depths.

GROUND LEVEL

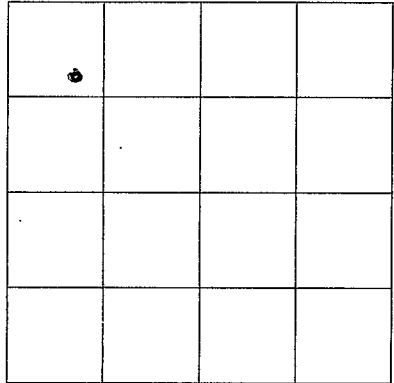

SECTION 25

Please indicate well location X.

ADDITIONAL INFORMATION

If more than one screen,  
show location of each on sketch.