

MISSISSIPPI DEPARTMENT OF NATURAL RESOURCES

Bureau of Land and Water Resources

Southport Mall

P.O. Box 10631

Jackson, Mississippi 39209

WATER WELL DRILLERS LOG

Coded

TIPPAH  
12851  
K 30

AUGUST 01, 1990

T. M. PARKS DRILLING & SALES CO.

TIPPAH

date well completed

firm name

county well located

LANDOWNER: J.D. HANKINS LUMBER CO.

description of formations encountered

from

to

POST OFFICE BOX 517

TOP SOILS & CLAYS

0

120

RIPLEY, MISSISSIPPI 38663

SANDY SHALES

120

250

(mailing address)

CLAYS, LIMESTONES, SANDY

250

290

WELL LOCATION:

SANDY SHALES

290

440

sec. 13 T. 4 N. S. R. 4 E. W. 3

LIMESTONE

440

680

6 1/2 M/HWY #4 miles EAST of RIPLEY

FINE SAND

680

700

(distance) (direction) (nearest town)

GUMBO & CLAYS

700

735

WELL PURPOSE: INDUSTRIAL (home, irrigation, municipal, industrial)

GOOD FINE SAND WITH SHALE

735

820

LIGNITE WITH SAND & FINE SHALE

DIRTY MATERIAL

820

870

WELL COMPLETION DATA:

(1) diameter (inches) 9 5/8"

(2) total depth (feet) 870'

T.D.

820'

(3) static water level (feet) below above top of ground.

(4) casing T&C SCH 40, 743' (material) (depth)

9 5/8" (size) if telescope see back.

(5) screen 60' (length) (depth to top)

6" (size) STAINLESS (material)

(6) pump 30 (HP) 150 (yield gpm)

440V 3Ø (type power)

(7) electric log YES (yes or no)

U. S. G. S. (organization running log)

(8) how well bottom plugged E.V.P 6" WITH SIN

RECEIVED

AUG 24 1990


Department of Natural Resources  
Bureau of Land & Water Resources

DRILLERS REMARKS:

SAND VERY FINE/YIELD LOW/1.5 GPF

If well telescopes please  
sketch and show depths.

GROUND LEVEL

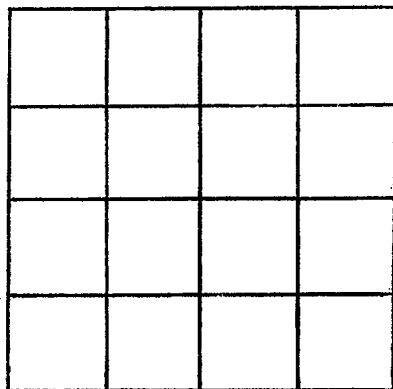

SECTION \_\_\_\_\_

Please indicate well location X.

ADDITIONAL INFORMATION

If more than one screen,  
show locations of each on sketch.