

TIPPAH

K

2001

MISSISSIPPI BOARD OF WATER COMMISSIONERS
416 North State Street
Jackson, Mississippi 39201

WATER WELL DRILLERS LOG

3-24-78
date well completed

19 Bryants Well Drilling
firm name

Tippah
county well located


LANDOWNER:	description of formations encountered	from	to
<u>Victor Roberts</u>	<u>Clay</u>	<u>0</u>	<u>40</u>
<u>Ripley Miss.</u> (mailing address)	<u>Sand</u>	<u>40</u>	<u>100</u>
WELL LOCATION: sec. <u>5</u> T. <u>4</u> N. R. <u>4</u> E	<u>Sand mixed with</u>	<u>100</u>	<u>160</u>
<u>7 1/2</u> miles <u>East</u> of <u>Ripley</u> (distance) (direction) (nearest town)	<u>Rock</u>		
WELL PURPOSE: (home, irrigation, municipal, industrial)			
WELL COMPLETION DATA:			
(1) diameter (inches) <u>4 1/2</u>			
(2) total depth (feet) <u>160</u>			
(3) static water level (feet) <u>110</u> <u>below</u> top of ground.			
(4) casing <u>Plas</u> <u>160</u> (material) (depth)			
<u>1013</u> If telescope see back. (size)			
(5) screen <u>10</u> <u>150</u> (length) (depth to top)			
<u>4 1/2</u> <u>Plas</u> (size) (material)			
(6) pump <u>1/2</u> <u>8</u> (HP) (yield gpm)			
(type power)			
(7) electric log (yes or no)			
(organization running log)			
(8) how well bottom plugged <u>Plas Cap</u>			
DRILLERS REMARKS:			

RECEIVED
AUG - 3 1978

MISS. BD. OF WATER COMMISSIONERS

If well telescopes please sketch and show depths.

GROUND LEVEL

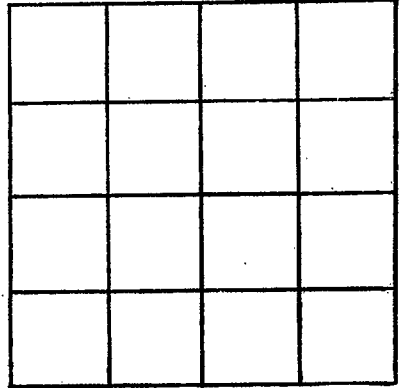

SECTION _____

Please indicate well location X.

ADDITIONAL INFORMATION

If more than one screen, show locations of each on sketch.